

Name Seymour Gould

Service No. 108

Address ~~150 Blossom Street~~ 21 Blossom Street (Per Eng. 11-2-66)

Location 150 Blossom Street

Kind of Pipe

Size

Size of Main

~~Repair~~ ~~Renewal~~ New Service

Com. 8-15-49

Location

Date	Material	Amount	Total	Date	Amount
June 28, '49	Labor	2 35	2 35	June 15, '49	35 00
	10% Overhead		24	July 25, '49	10 13
	53' - 3/4" Copper Tubing @.24	12 72	12 72		24 35
	1 - 3/4" C x 1/2" I.W.P. S&W	3 29	3 29		19 50
	Trucking 1 hr.		75	June 28, '49	19 50
	Patching 3 x 3		3 00	11' - 3/4" Copper Tubing @.24	2 64
			22 35	1 - 3/4" C Corp-cock	3 15
				1 - 3/4" C x 3/4" C Curb-cock	3 85
				1 - Box & Rod	3 95
				1 - 1/2" Straight Tail Piece	37
				1 - 1/2" Offset Tail Piece	37
				Trucking 1 hr. @.75	75
					34 58
	Labor				

*Deposited*  
*Chin...*  
Non-Charge

# TOWN OF LEXINGTON - BOARD OF PUBLIC WORKS

## WATER DIVISION

The undersigned applies for a supply of water at No..... St. and hereby agrees to comply with the rules and regulations as now, or at any future time, established by the Board of Selectmen.

Am't of Estimate \$.....

Owner .....


Am't Paid \$.....

Address .....

Builder .....

.....

Sketch of Service Here

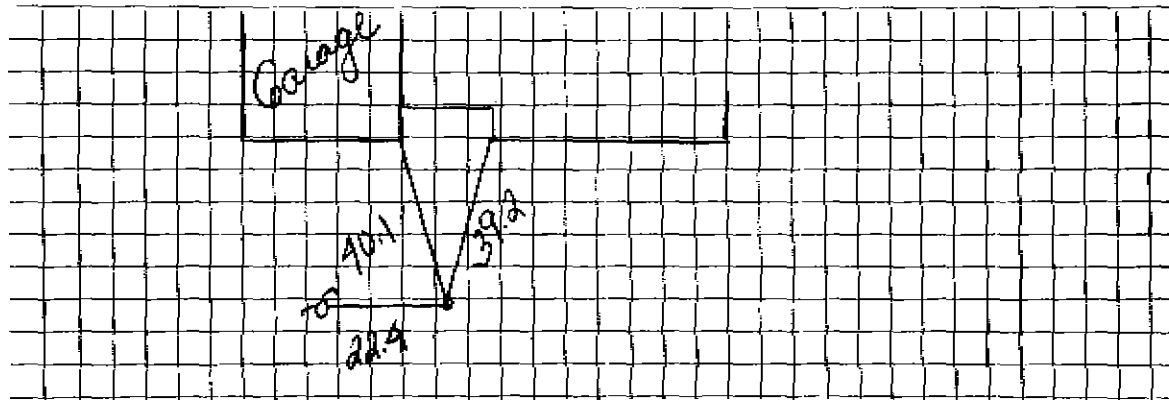

Connection made in ..... Street.

Work completed .....19

Remarks: