




DATE \_\_\_\_\_

TOWN OF LEXINGTON — BOARD OF PUBLIC WORKS

WATER DIVISION

Sketch of Service Here

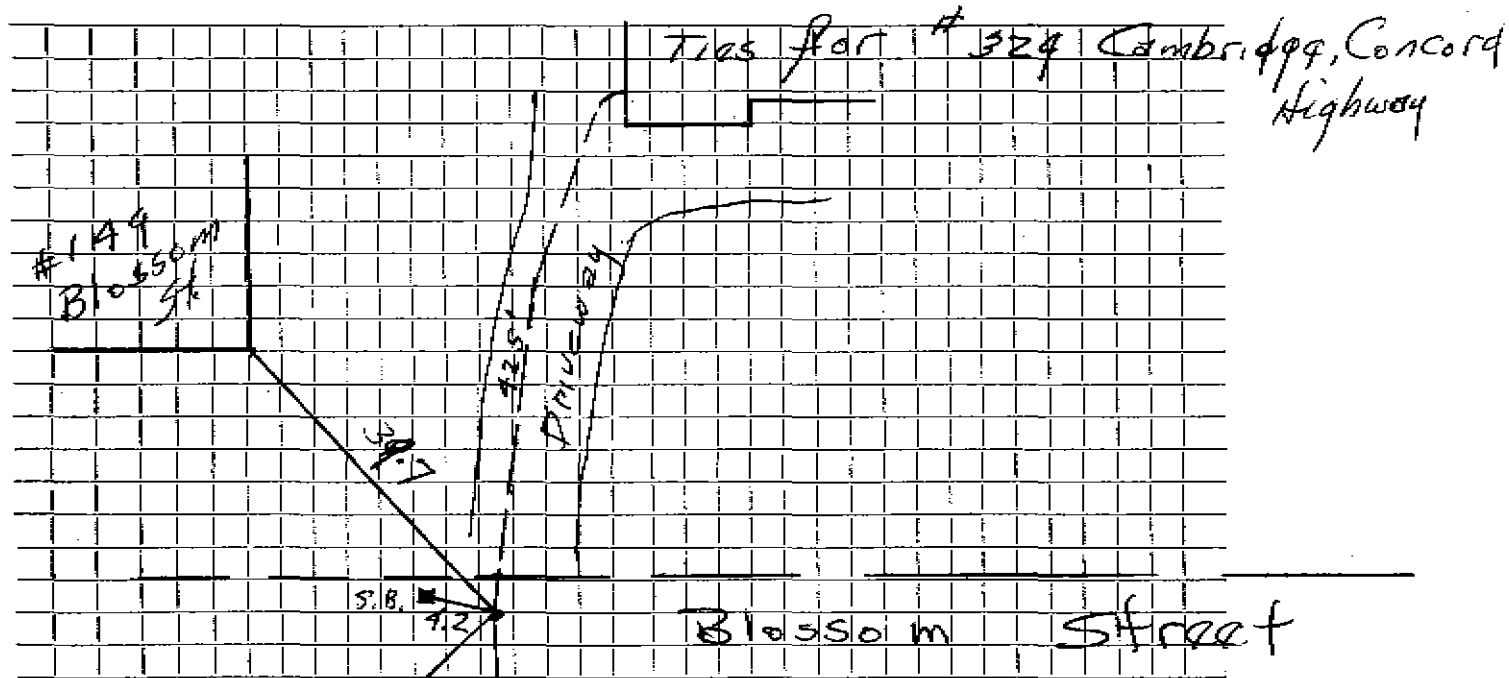

Connection made in ..... Street ..... Work completed .....

Remarks: .....

5.4  
R. Hyd.  
3.2  
4.2  
11/10