

WATER SERVICE RECORD

4146

Name Harry Bowman

Service No. 110

Address ~~XXXXXXXXXXXXXXXX~~ 25 Blossom Street (Per Eng. 11-2-66)

Location

~~REPAIR~~ Renewal ~~NEW SERVICE~~ W.O. #8228


MAR 23 1964

Date	Material	Amount	Total	Date	Amount
11/4/63	Labor	45 05		11-8-63	300 00
	10% Overhead	4 51	49 56	7-23-64	207 16
	89' 3/4" Copper tubing @ .42		21 36		72 84
	1 3/4" Cx 1/2 I.W.H. Stop & Waste		6 17		
	3 x 3 Patch		3 00		NON CHARGE
	1 1/2 hrs. Town Shovel @ 6.50		9 75	11/4/63	Labor
	1 hr. Trucking		3 00	7'	3/4" Copper tubing @ .42
			92 84	1	3/4" Curb Cock
				1	1" Curb Cock
	RELOCATE WATER SERVICE - W.O. #4931			1	1" x 1" Tee Brass
6/26/67	Labor		28 98	2	1" x 1" 2-part Unions @ 2/10
	14' 3/4" Copper tubing @ .79		11 06	1	3/4" 3-part Union
	1 3/4" Corporation		7 42	1	Box & Rod
	1 Curb Box		5 45	1/2	hr. Town Shovel @ 6.50
	1 Hr. Trucking		3 00	1	hr. Trucking
	2 Hrs. Shovel @ 6.50		13 00		
			68 91		

DATE _____

TOWN OF LEXINGTON — BOARD OF PUBLIC WORKS
WATER DIVISION

Sketch of Service Here

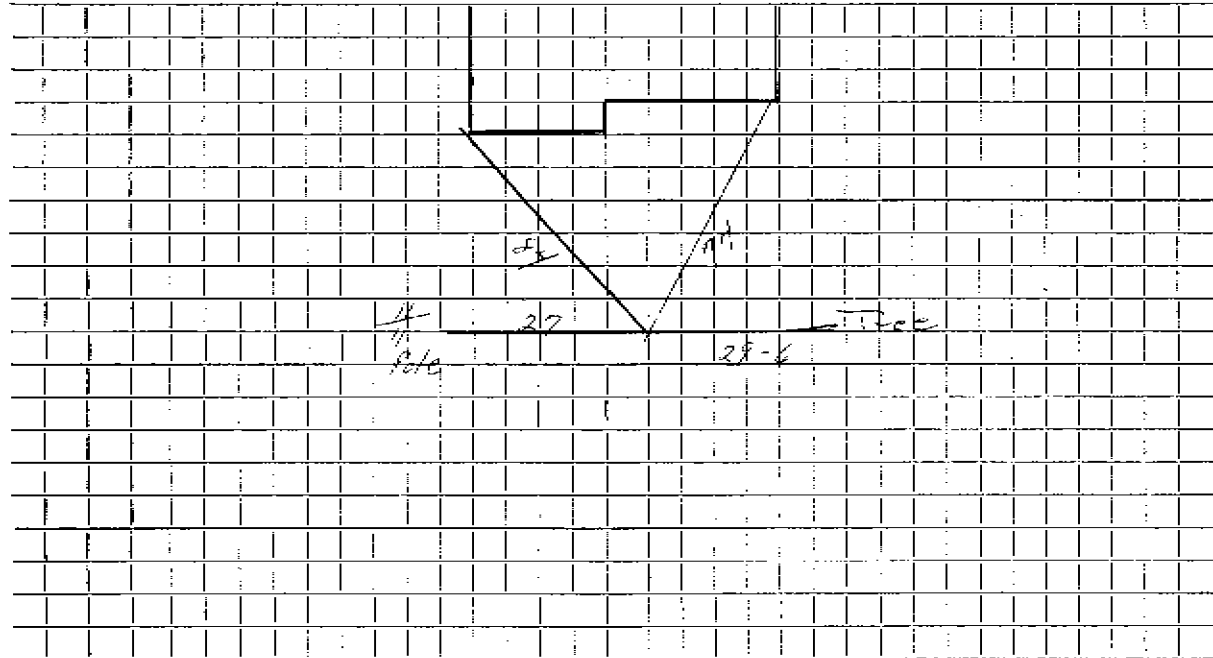

Connection made in Street. Work completed

Remarks:
.....
.....