

WATER SERVICE RECORD

Name

Service No. 819

Address 26 Blossom St.

Location Lexington Mass

Repair—Renewal—New Service


Date	Material	Amount	Total	Date	Amount
6-17-47	1-3/4" C x 1/2"	I.W.H. Saw			
	1-3/4" C x 1/2"	I. UNION	2 ps		
				6-16-47	
				17	
6-26-67					
	16' 3/4" COPPER TUBING				37' 3/4 TUBING
	1 3/4" CORP.				1 3/4 CORP COCK
					1 3/4 C x 3/4 CORB COCK
					1 BOX + ROD

DATE _____

TOWN OF LEXINGTON — BOARD OF PUBLIC WORKS

WATER DIVISION

Sketch of Service Here

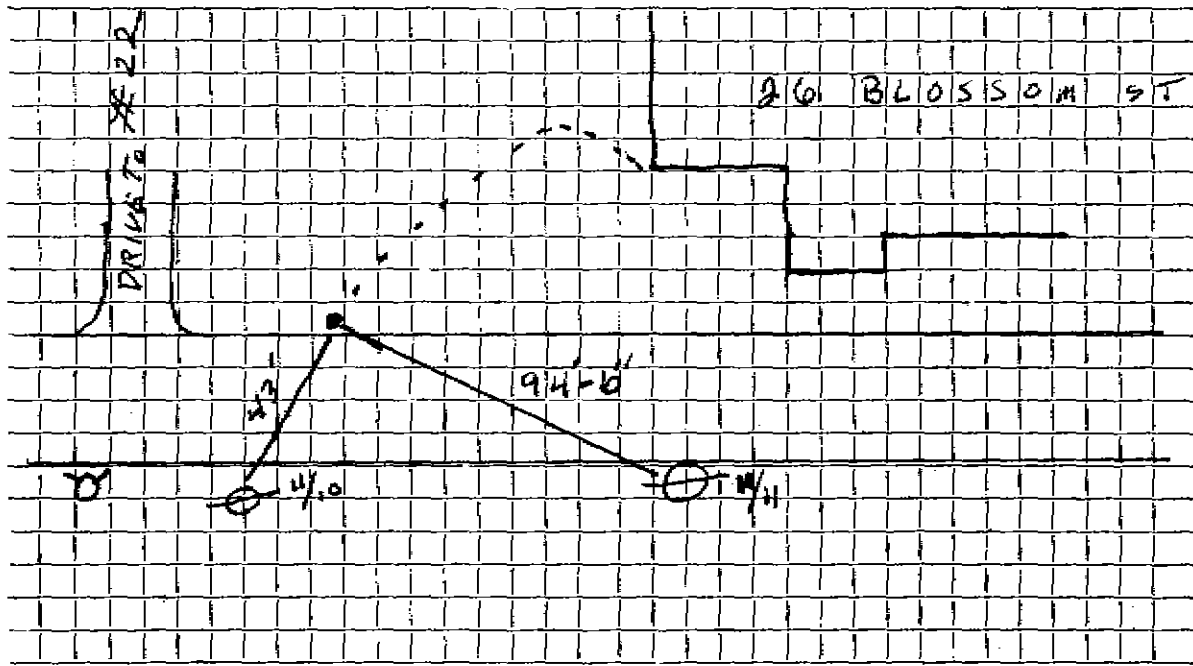

Connection made in Street. Work completed

Remarks:
.....
.....