

## WATER SERVICE RECORD

Name Alfred E. Chiacchia

Service No. 72

Address ~~28 Blossom Street~~ 28 Blossom Street (Per Eng. 11-2-65)

Location

Repair  
 Renewal  
 New Service

Comm 8-1-60


Date	Material	Amount	Total	Date	Amount	
5-26-60	Labor	31 02		5-24-60	Deposit	350 00
	10% O.H.	3 10	34 12	27-60	Retard	112 06
	81' 1" Copper tubing @4676		37 88			<del>237 94</del>
	1 1" 1x3/4 C.W.H. Stop&Waste		6 96			
	1 1" C3 part Union		3 98		NON CHARGE	
	4 Hrs. Trucking @3.00		12 00	300'	1" Copper tubing @4676	-140.28
	1 Hr Trojan Loader @3.00		3 00	1	1" C Corp Cock	7 31
	2 Hrs Town Shovel @6.50		13 00	2	1" C Curb Cocks	8 06
	1 Hr Bogars Trailer @3.00		3 00	2	Box & Rods @5.00	10 00
	2 Hrs Roller @2.00		4 00	61'	3 part Unions @3.98	23 88
	24 Ton Patch @5.00		120 00	6	Hrs Town Shovel @6.50	39 00
			237 94	3	Hrs Trucking @75	2 25
				5	Hrs Trojan Loader @3.00	-15.00
	RELOCATE WATER SERVICE W.O. #4933				Labor	89 60
6/26/67	Labor		28 98			335 38
	14' 1" Copper tubing @ .99		13 86			
	1 1" Corporation		10 66			
	1 Hr. Trucking		3 00			
	2 Hrs. Shovel @ 6.50		13 00			
			69 50			

DATE \_\_\_\_\_

TOWN OF LEXINGTON — BOARD OF PUBLIC WORKS

WATER DIVISION

Sketch of Service Here

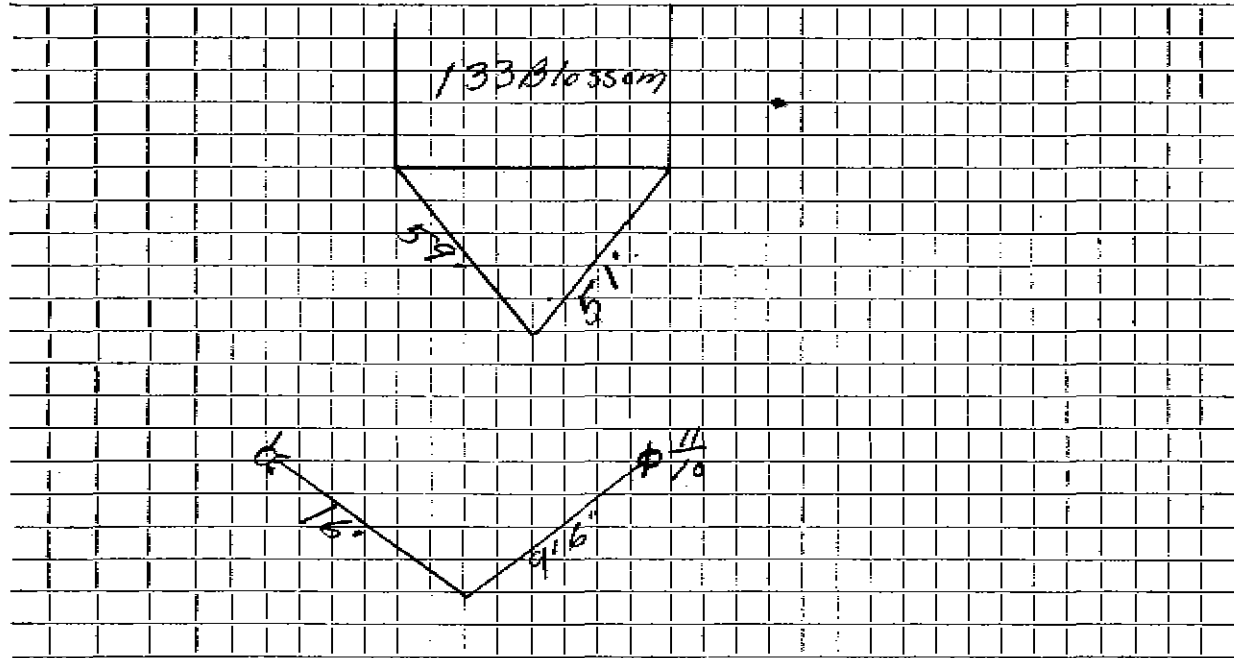

Connection made in ..... Street. Work completed .....

Remarks: *2 Cur. b. Boxes... one down s. street from House*