

Name Peter Ronchetti

Service No.

Address ~~193 Blossom Street~~ 4 Blossom Street (Eng. 11-2-66)

Lexington, Mass

Location ~~193 Blossom Street~~

3916

Kind of Pipe

Size

Size of Main

~~Repair~~ ~~Renewal~~ New Service

Com. 6-14-49

Location

Date	Material	Amount	Total	Date	Amount
Apr. 25, '49	Labor	3 65	3 65	Apr. 18 '49	Deposited 75 00
	10% Overhead		37	June 24 '49	Refunded 16 49
	35' - 3/4" Copper Tubing @.27		9 45		Non-Charge 58 51
	1 - 3/4" C x 1/2" I.W.H. S&W		3 29	Apr. 25, '49	Labor 5 70
	Littlefield Shovel 3 hrs. @7.00		21 00		28' - 3/4" Copper Tubing @.27 7 56
	Trucking 1 hr. @.75		75		1 - 3/4" C Corp-cock 3 15
	Patching 20 x 3		20 00		1 - 3/4" C x 3/4" C Curb-cock 3 85
			58 51		1 - 3/4" C x 3/4" C Union (3pts) 1 39
					1 - Box & Rod 3 95
					1 - 1/2" Offset Tail Piece 37
					1 - 1/2" Straight Tail Piece 37
					Littlefield Shovel 2 hrs. @7.00 14 00
	Labor				Trucking 1 hr. @.75 75
					41 09

TOWN OF LEXINGTON - BOARD OF PUBLIC WORKS

WATER DIVISION

The undersigned applies for a supply of water at No..... St. and hereby agrees to comply with the rules and regulations as now, or at any future time, established by the Board of Selectmen.

Am't of Estimate \$.....

Owner


Am't Paid \$.....

Address

Builder

.....

Sketch of Service Here

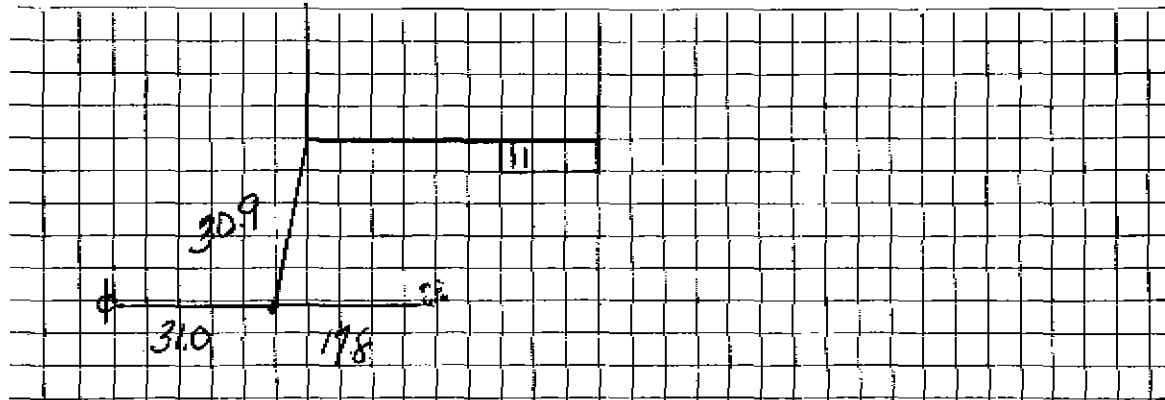

Connection made in Street.

Work completed19

Remarks: