




DATE \_\_\_\_\_

TOWN OF LEXINGTON — BOARD OF PUBLIC WORKS

WATER DIVISION

Sketch of Service Here

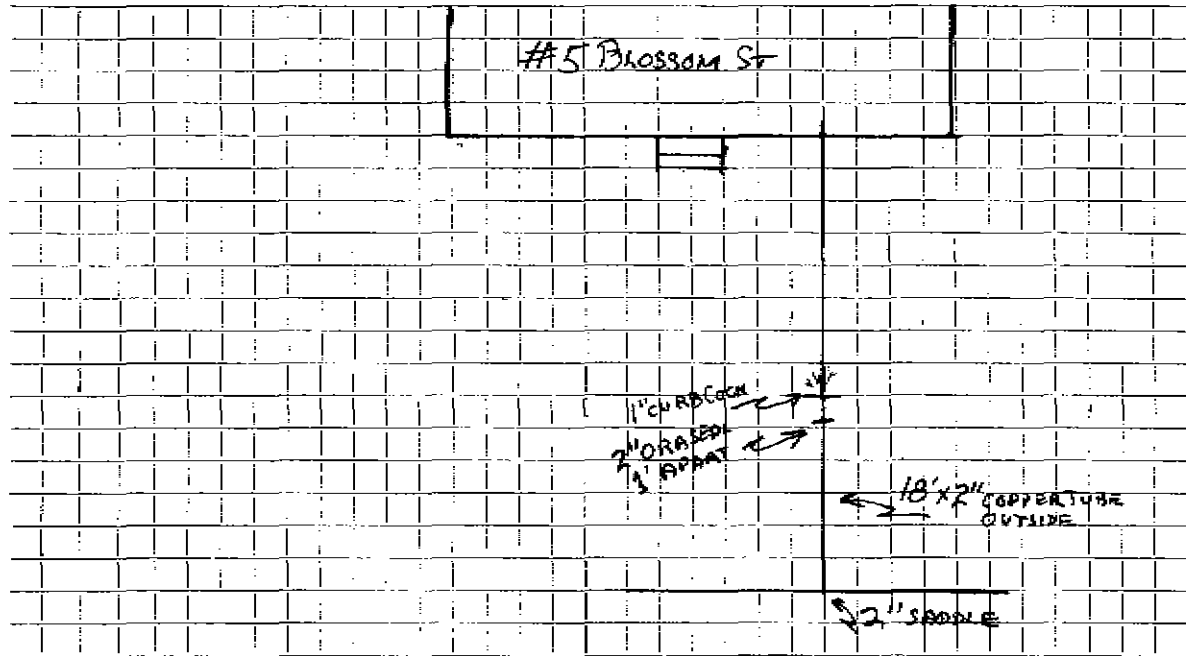

Connection made in ..... Street. Work completed .....

Remarks: NEW HOUSE BUILT ON SITE OF OLD GREEN HOUSE & FARM — 2" COPPER TO EDGE OF ROAD  
UTILIZED FOR HOUSE SERVICE