

Name Courtney Comeau

Service No. 157

Address ~~XXXXXXXXXXXXXXXXXXXX~~ 6 Blossom Street (Eng. 11-2-66)

Location ~~XXXXXXXXXXXXXXXXXXXX~~ 187 Blossom Street

Kind of Pipe

Size

Size of Main

~~Repair or Renewal~~ - New Service

Com. 9-19-49

Location

Date	Material	Amount	Total	Date	Amount
Aug. 10, '49	Labor	3 05	3 05	July 29, '49	30 00
	10% Overhead		31	Sept 20, '49	8 16
	31' - 3/4" Copper Tubing @ .24	7 44	7 44	Deposited	
	1 - 3/4" C x 1/2" I.W.H. S&W	3 29	3 29	Refunded	
	Littlefield Shovel 1 hr.	7 00	7 00	Non-Charge	
	Trucking 1 hr.	75	75	Aug. 10, '49	3 05
	Patching 20 x 3	20 00	20 00	29' - 3/4" Copper Tubing @.24	6 96
		41 84	41 84	1 - 3/4" C Corp-cock	3 15
				1 - 3/4" C x 3/4" C Curb-cock	3 85
				1 - Box & Rod	3 95
				1 - 1/2" Offset Tail Piece	37
				1 - 1/2" Straight Tail Piece	37
				Littlefield Shovel 2 hrs. @7.00	14 00
				Trucking 1 hr.	75
	Labor				<u>36.45</u>

DATE _____

TOWN OF LEXINGTON – BOARD OF PUBLIC WORKS

WATER DIVISION

The undersigned applies for a supply of water at No..... St. and hereby agrees to comply with the rules and regulations as now, or at any future time, established by the Board of Selectmen.

Am't of Estimate \$.....

Owner


Am't Paid \$.....

Address

Builder

.....

Sketch of Service Here

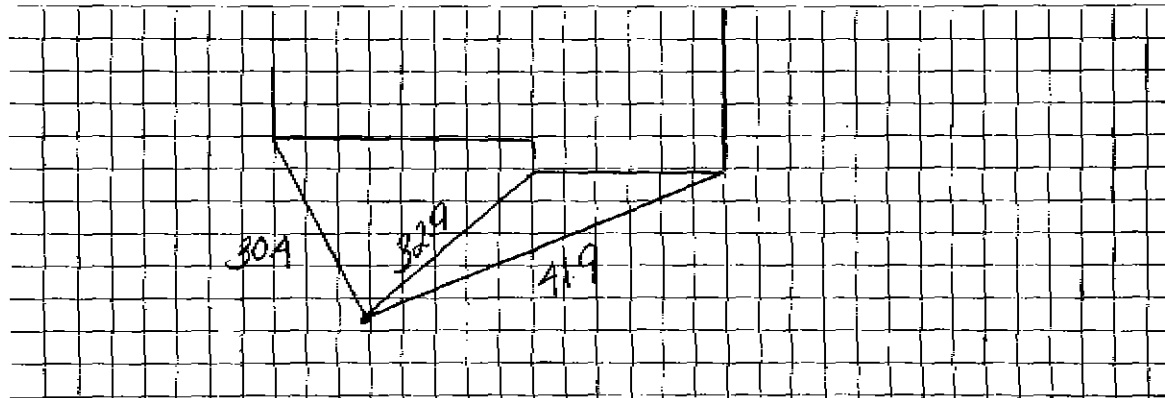

Connection made in Street.

Work completed19

Remarks: