


DATE 7/20/16

TOWN OF LEXINGTON — BOARD OF PUBLIC WORKS

WATER DIVISION

Sketch of Service Here

PW
5' DEPTH

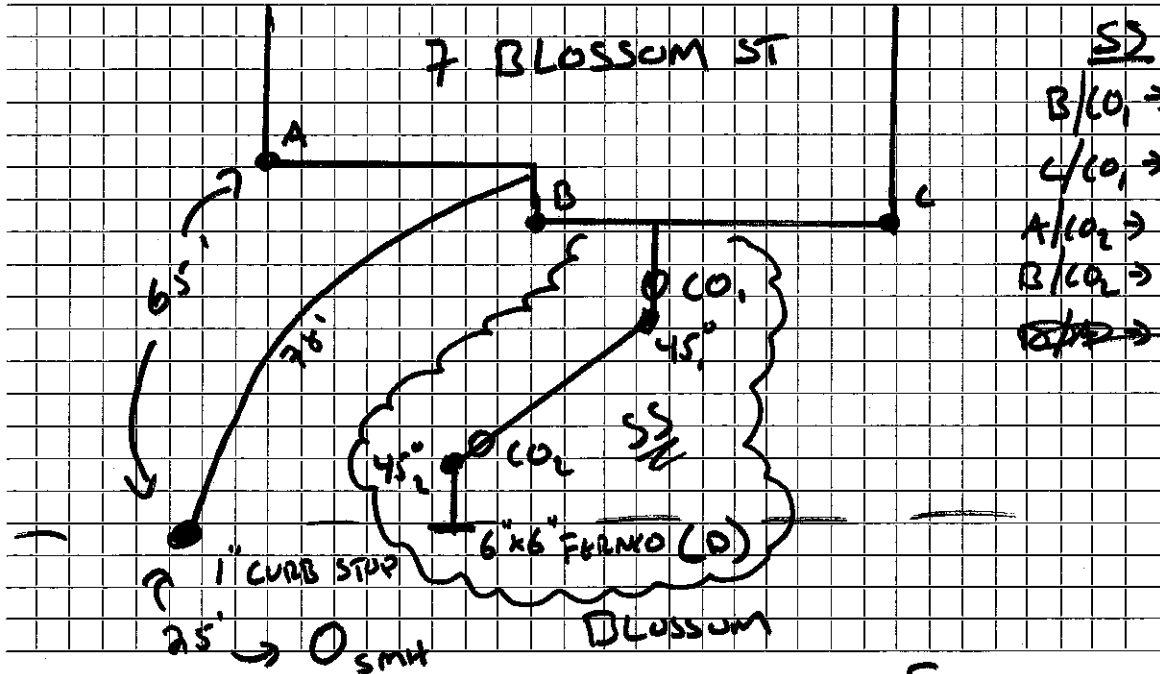

SS
 B/CO₁ → 11'2"
 C/CO₁ → 29'6"
 A/CO₂ → 20'8"
 B/CO₂ → 27'4"
~~27'4"~~

Connection made in Dlossum Street. Work completed FINNIGAN

Remarks: