

## WATER SERVICE RECORD

Name Kenneth G. Briggs Planning Director; Planning Board Office

Service No. 50

Address 100 Blossomcrest Rd.

Location

~~Repair~~ ~~Renewal~~ ~~New Service~~ WO #4434 Deflice Bros. #2784

OCT 25 1976


Date	Material	Amount	Total	Date	Amount
<del>10/21/75</del>	Labor	18 93		10-31-75	Deposit
11/21/75	10% OH	1 89	20 82		100 00
28'	3/4" copper tubing @ .67		18 70		
1	3/4 corporation		3 53		
1	3/4 curb stop		2 40		
1	box and rod		3 80		
1/2 ton	cold patch		3 25		
1/2 hr	compressor @ 5.00		2 50		
	6' X 12' X 2" patch		45 00		
			100 00		
12/1/75 41'	3/4" Copper Tubing				

DATE \_\_\_\_\_

TOWN OF LEXINGTON — BOARD OF PUBLIC WORKS

WATER DIVISION

Sketch of Service Here

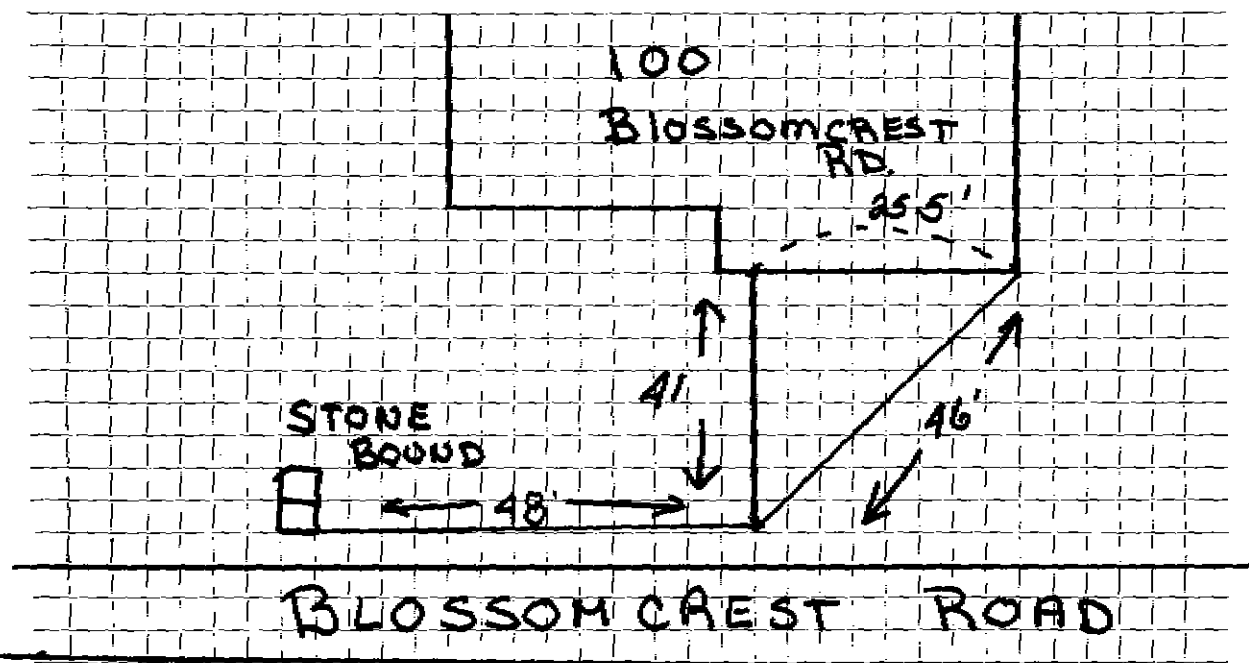

Connection made in ..... Street. Work completed .....

Remarks: .....  
.....  
.....