

WATER SERVICE RECORD

Name Theodore L. Freeman, Jr. Huckleberry Lane, Acton

Service No. 60

Address 104 Blossomcrest Street

Location

~~REPAIRS~~ ~~REPAIRS~~ - New Service W.O. #3858. Arlex Permit #2787.


MAR 15 1976

Date	Material	Amount	Total	Date	Amount
12/19/75	Labor	71.15			
	10 % O.H.	<u>7.12</u>	\$ 78.27		
	25' (37) 3/4" Copper Tubing @.67		16.08	12-4-75	Deposit
1	3/4" Corporation		10.53		Cost
1	3/4" Curb Stop		13.72		
1	Curb Box & Rod		15.40		
1	Hr. Trucking		3.00		
2	Hrs. Town Shovel @6.50		13.00		
			\$150.00		

DATE _____

TOWN OF LEXINGTON — BOARD OF PUBLIC WORKS
WATER DIVISION

Sketch of Service Here

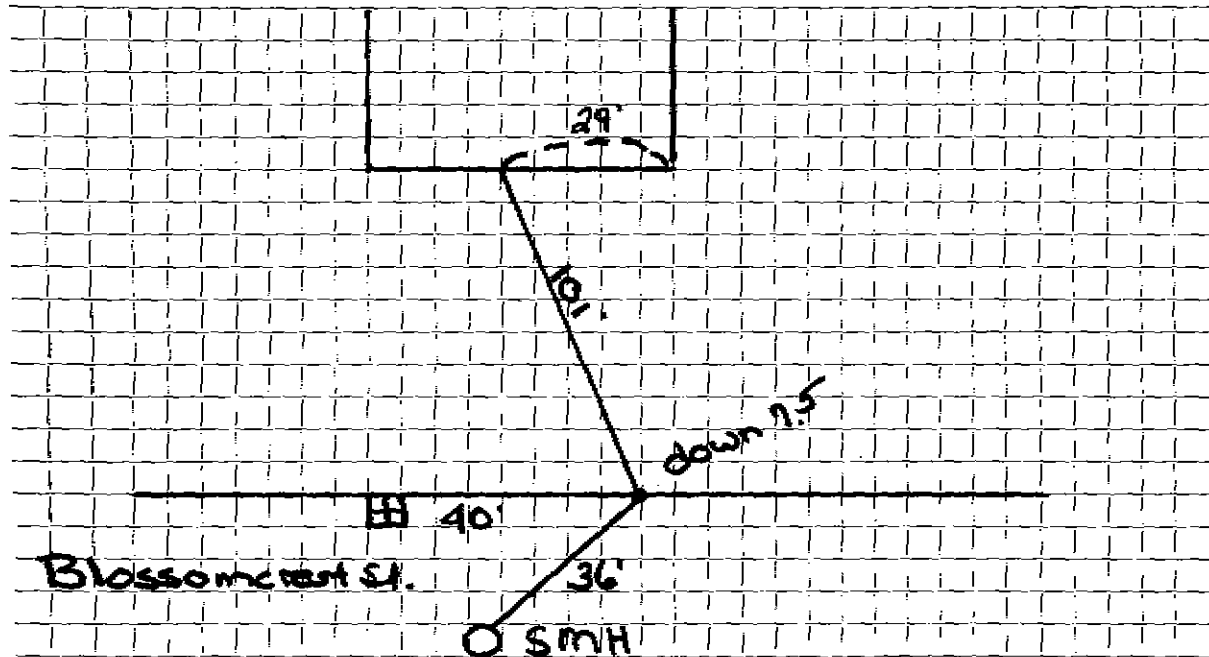

Connection made in Street. Work completed

Remarks:
.....
.....