

WATER SERVICE RECORD

Name Peter Gaillard

Service No. 24

Address 106 Blossomcrest Road

Location

~~Repair/Alteration~~ New Service W.O. #3326.

Eagle #2681


Comm 7-28-75

Date	Material	Amount	Total	Date	Amount	
5-22-75	Labor	20.76		<i>5-9-75</i>	<i>Deposit</i>	<i>150.00</i>
	10% O.H.	<u>2.08</u>	\$22.84	<i>7-28-75</i>	<i>Retund</i>	<i>29.43</i>
28'	1" Copper Pipe	@1.30	36.40			<i>120.59</i>
1	1" Corporation		16.69			
1	1" Curb Stop		19.57			
1	1" 3 Part Union		8.17			
1	Box & Rod		15.40			
1	Hr. P.U.		<u>1.50</u>			
			\$ 120.57			

DATE _____

TOWN OF LEXINGTON — BOARD OF PUBLIC WORKS
WATER DIVISION

Sketch of Service Here

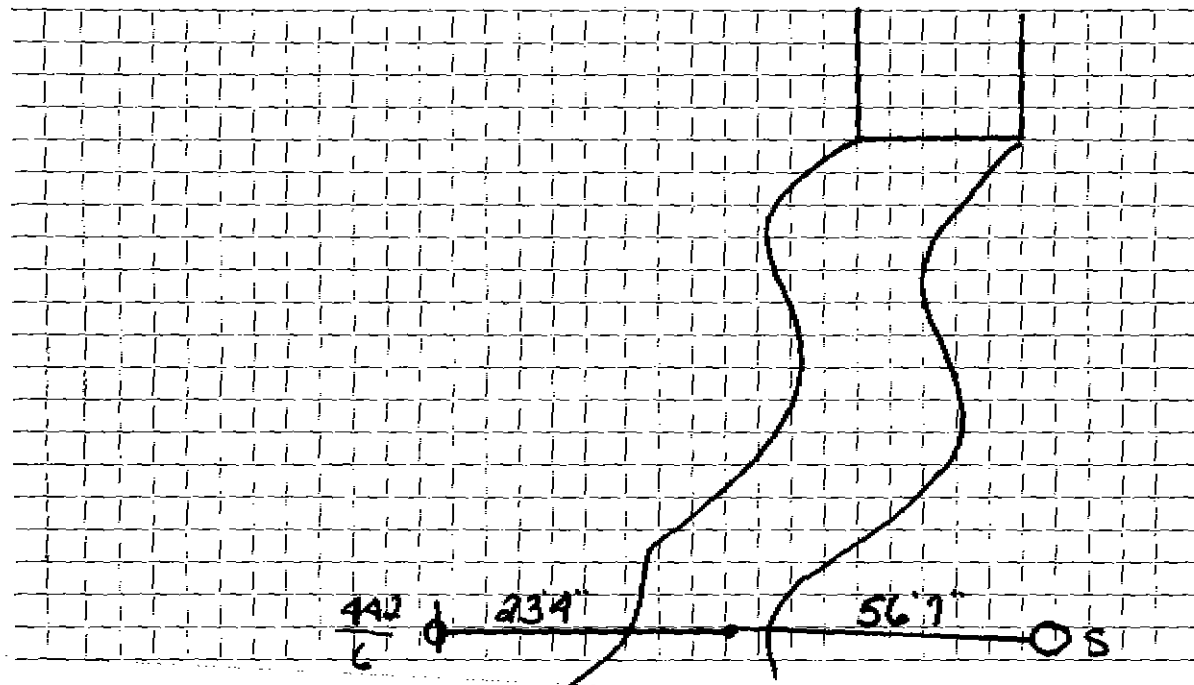

Connection made in Street. Work completed

Remarks:
.....
.....