


Date: 3/8/24

TOWN OF LEXINGTON - BOARD OF PUBLIC WORKS
WATER DIVISION

SKETCH OF SERVICE HERE
107 BLOSSOM CREST RD

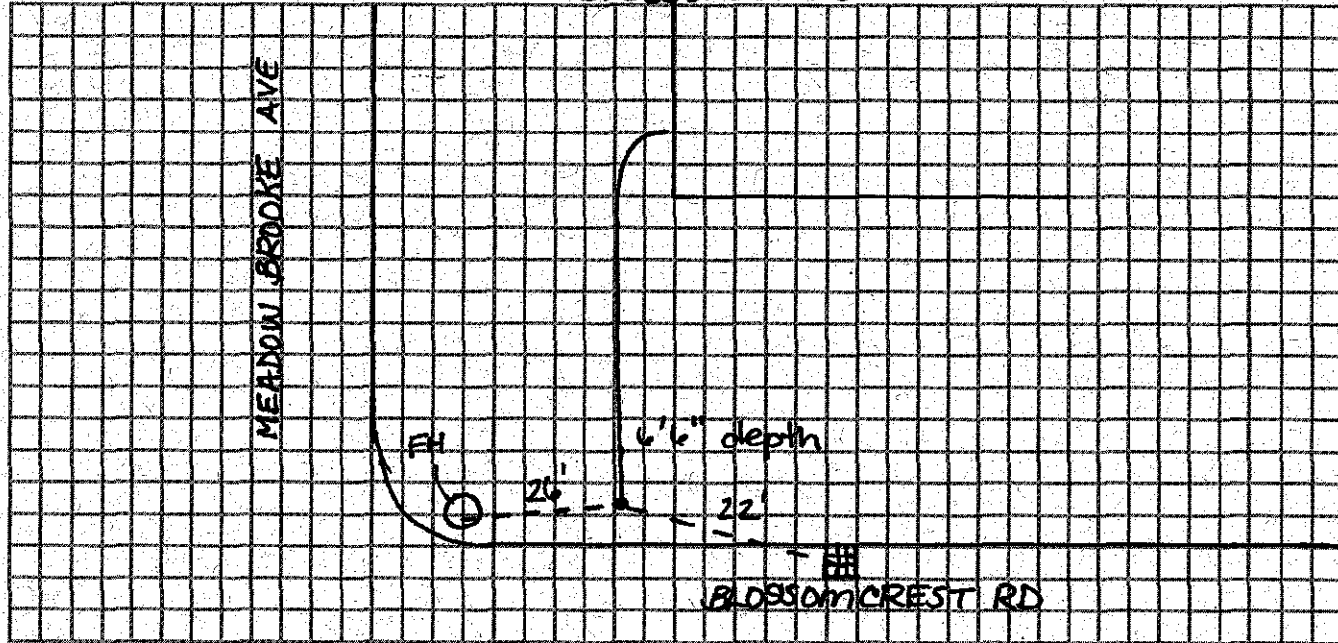

Connection made in:

Street:

Work completed:

Remarks: Installed by J.M. McLaughlin inc.

