

WATER SERVICE RECORD

Name Joseph Vecchione

Service No. 275

Address 12 Blossomcrest Road

Location Lexington, Mass.

~~REPAIR~~ Renewal - ~~NEW SERVICE~~

*Com. 12-3-51*


Date	Material	Amount	Total	Date	Amount
11/6/51	Labor	1 65	1 65	10-30-51	Deposited 20 00
	10% overhead		17	1-6-51	Paid (6 13
	60' - 3/4" copper tubing @ .326		19 56		<u>NON CHARGE</u> 26 13
	1 - 3/4" Cx 1/2 I.W.H. stop & waste	4 00		11/6/51	Labor 1 65
	1 hr. trucking		75	10' - 3/4" copper tubing @ .326	3 26
	TRENCH DUG BY OWNER		26 13	1 - 3/4" C. corp-cock	4 35
				1 - 3/4" Cx 3/4" C. curb-cock	4 67
				1 - box and rod	4 68
				1 - 1/2 offset tail piece	50
				1 - 1/2 straight tail piece	50
				1 - hr. trucking	75
					20 34
				<i>bill out 12-3-51</i>	

DATE \_\_\_\_\_

# TOWN OF LEXINGTON — BOARD OF PUBLIC WORKS

## WATER DIVISION

Sketch of Service Here

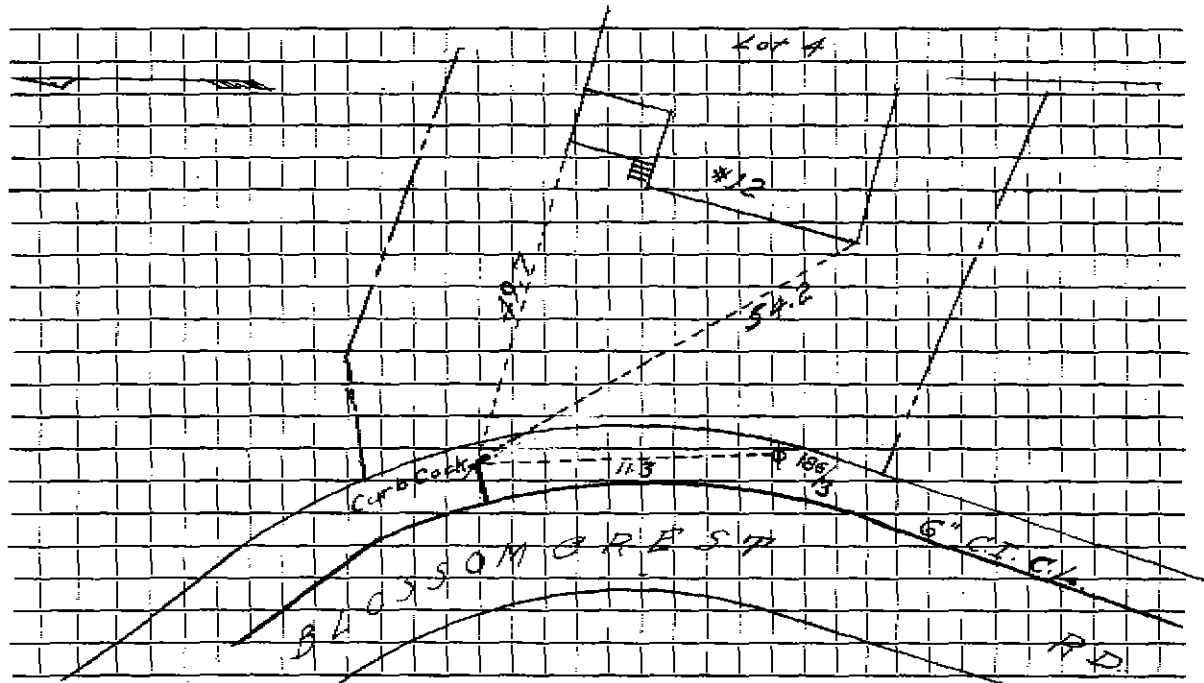

Connection made in ..... Street. .... Work completed .....

Remarks: .....

.....

.....