

WATER SERVICE RECORD

#4477
#6612
96

Name Mrs. Carl Sweeney

Service No.

Address 16 Blossomcrest Road

Location

~~Report~~ New Service W.O. #8196

Comm 10-28-63


Date	Material	Amount	Total	Date		Amount
9/20/63	Labor	35 47		9-13-63	Deposit	125 00
	10% O.H.	3 55	39 02	10-28-63	Retard	32 25
	53' 3/4" Copper Tubing @ .42		22 26			92 95
	1 3/4" Cx 1/2 I.W.H. Stop & Waste		6 17			
	3 Hrs. Town Shovel @ 6.50		19 50	9/20/63	Labor	7 37
	2 Hrs. Trucking @ 3.00		6 00		11' 3/4" Copper Tubing @ .42	4 62
			92 95		1 3/4" C Gurb Cock	6 28
					1 Bow & Rod	4 90
					1 1/2 Straight Tailpiece	50
					1 1/2 Offset Tailpiece	50
					1 Hr. Town Shovel @ 6.50	6 50
					1 Hr. Trucking @ 3.00	3 00
					1 3/4" C Corp Cock	4 91
						38 58

TOWN OF LEXINGTON — BOARD OF PUBLIC WORKS

WATER DIVISION

DATE _____

Sketch of Service Here

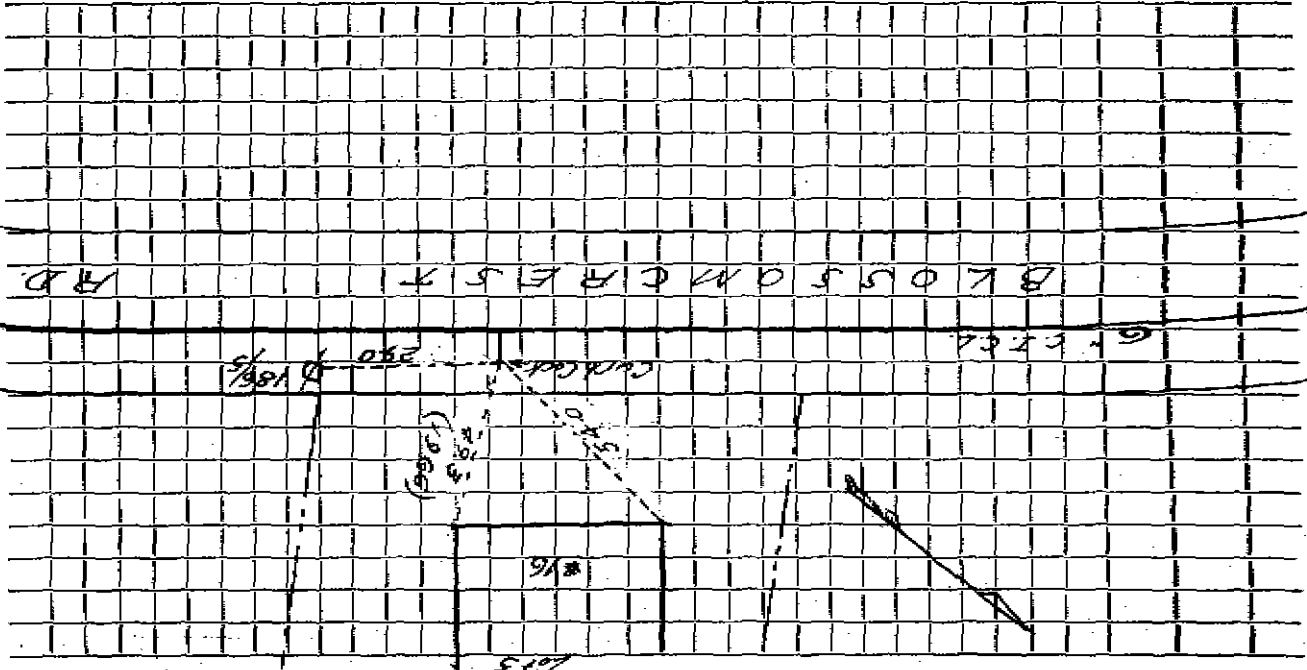

Connection made in _____ Street. _____ Work completed

Remarks: _____