

Name Oscar Carlson

## WATER SERVICE RECORD

Service No. 102 #5362

#5361

Address 17 Blossomcrest Rd.

Location Lexington

~~Repair - Renewal~~ - New Service

Com. 7-28-52


Date	Material	Amount	Total	Date	Amount
6/18/52	Labor	3 02		6-3-52 Deposited	40 00
	10% Overhead	30	3 32	7-24-52 Refunded	7 23
	50' - 3/4" copper tubing @ .3439	17 20			<u>NON CHARGE</u>
	1 - 3/4" C x 1/2 I.W.H. stop & waste	4 00		6/18/52 Labor	3 02
	1 hr. Littlefield shovel	7 00		24' - 3/4" Copper tubing @ .3439	8 25
	1 hr. trucking		75	1 - 3/4" C. Corp-cock	4 33
			32 27	1 - 3/4" C x 3/4" C. Curb-cock	4 67
				1 Box and Rod	4 52
				1 - 1/2" straight tail piece	50
				1 - 1/2" offset tail piece	50
				1 hr. Littlefield shovel	7 00
				1 hr. trucking	75
					<u>33 54</u>

DATE \_\_\_\_\_

TOWN OF LEXINGTON — BOARD OF PUBLIC WORKS

WATER DIVISION

Sketch of Service Here

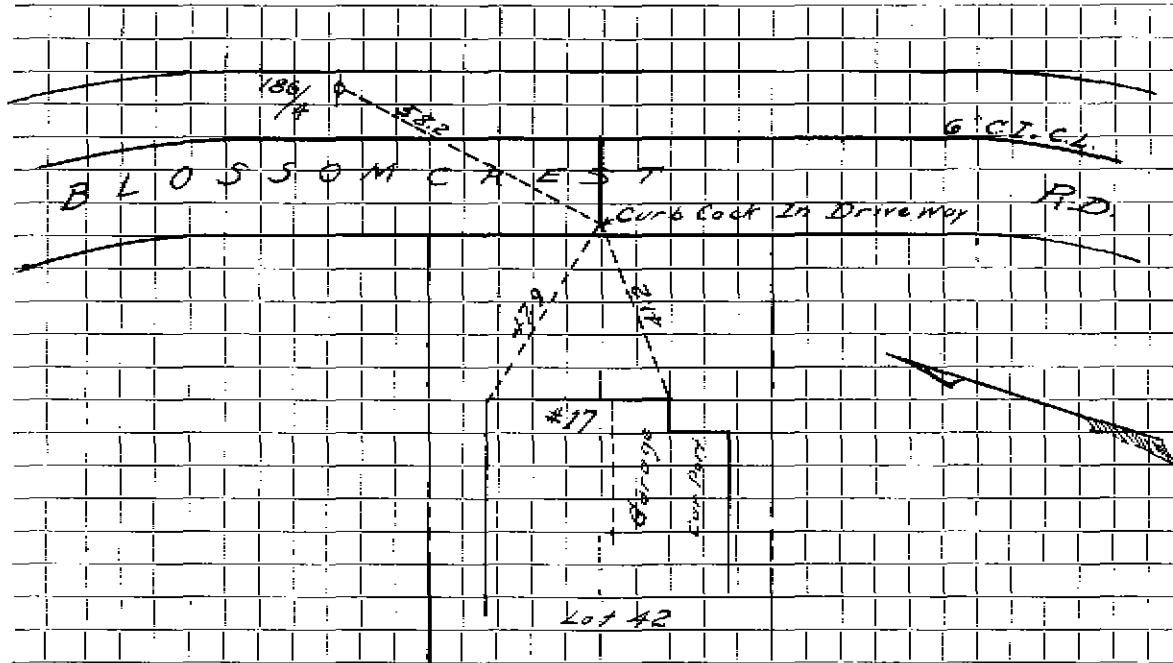

Connection made in \_\_\_\_\_ Street. Work completed \_\_\_\_\_

Remarks: \_\_\_\_\_

\_\_\_\_\_

\_\_\_\_\_