

WATER SERVICE RECORD

Name Earle Prentiss

Service No. 197

Address 22 Blossomcrest Road

Location

~~Repair~~ ~~Renewal~~ New Service

Com. 9-6-55


Date	Material	Amount	Total	Date	Amount
7/29/55	Labor	10 68		6-29-55	Deposited 125 00
	10% overhead	1 07	11 75	9-6-55	Refunded 43 96
	105'-3/4" copper tubing @.384	40 32			NON CHARGE 81 04
	1-3/4"-3part union		1 72	7/29/55	Labor
	1-3/4"C x 1/2" I.W.H. stop & waste	4 00			15'-3/4" copper tubing @.384
	3 hrs. Littlefield shovel @ 7.50	22 50			1-3/4"C corp-cock
	1 hr. trucking @ .75		75		1-3/4"C x 3/4" curb-cock
			81 04		1- box and rod
					1-1/2" offset tail piece
					1-1/2" straight tail piece
					1 hr. Littlefield shovel @7.50-
					1 hr. trucking @.75
					31 47

DATE _____

TOWN OF LEXINGTON — BOARD OF PUBLIC WORKS

WATER DIVISION

Sketch of Service Here

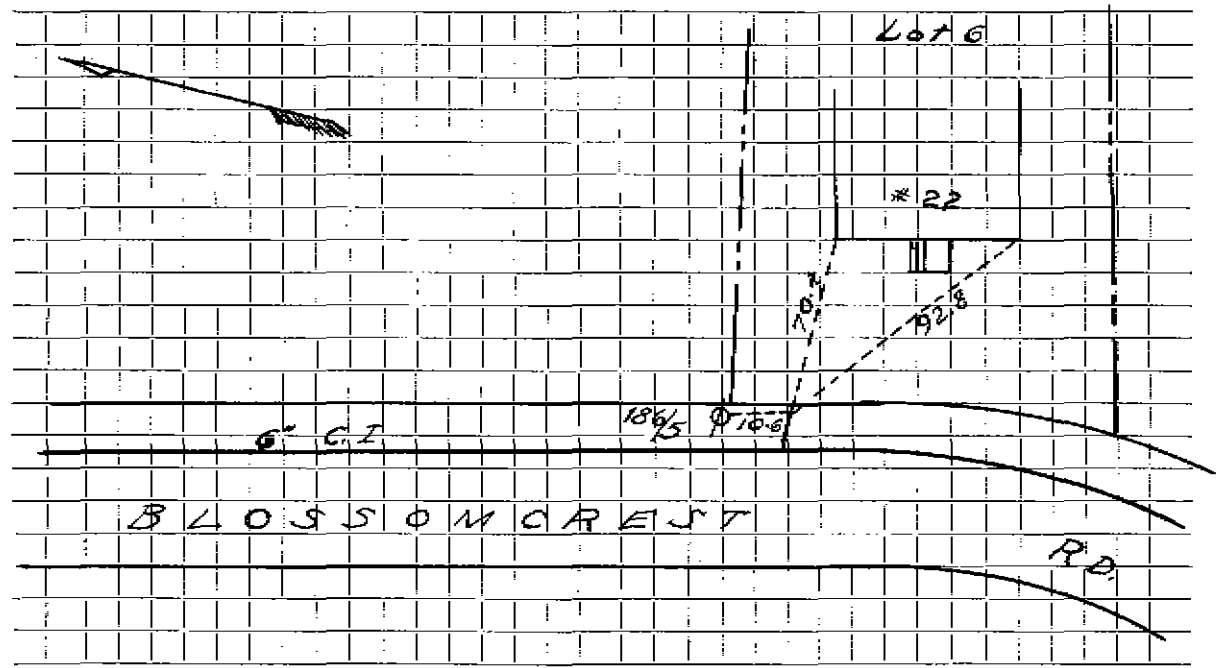

Connection made in _____ Street _____ Work completed _____

Remarks:
.....
.....