

WATER SERVICE RECORD

#1815

Name Donald Ranagan

Service No. 249

Address 29 Blossomcrest Road

Location

~~Repair~~—~~Renewal~~—New Service COM. 10-31-55

Date	Material	Amount	Total	Date	Amount	
8-12-55	Labor	6 81		8-5-55	70 00	
	10% overhead	68	7 49	11-1-55	31 82	
	35' - 3/4" copper tubing@.384		13 44		38 18	
	1 - 3/4" Cx 1/2" I.W.H. stop & waste		4 00	8-12-55	Labor	6 81
	1 hr. trucking@.75		75	15' - 3/4" coppertubing@.384		5 76
	1-2/3hrs. Littlefield shovel@7.50		12 50	1 - 3 pt. union		1 72
			38 18	2/3 hr. Littlefield shovel@7.50		5 00
				1 - 3/4" c. corp-cock		4 33
				1 - 3/4" c. curb-cock		4 67
				1 box and rod		3 90
				1 - 1/2 straight tail pc.		50
				1 - 1/2 offset tail pc.		50
						33 19


*Deposited*  
*Refunded*  
NON CHARGE

DATE \_\_\_\_\_

TOWN OF LEXINGTON — BOARD OF PUBLIC WORKS

WATER DIVISION

Sketch of Service Here

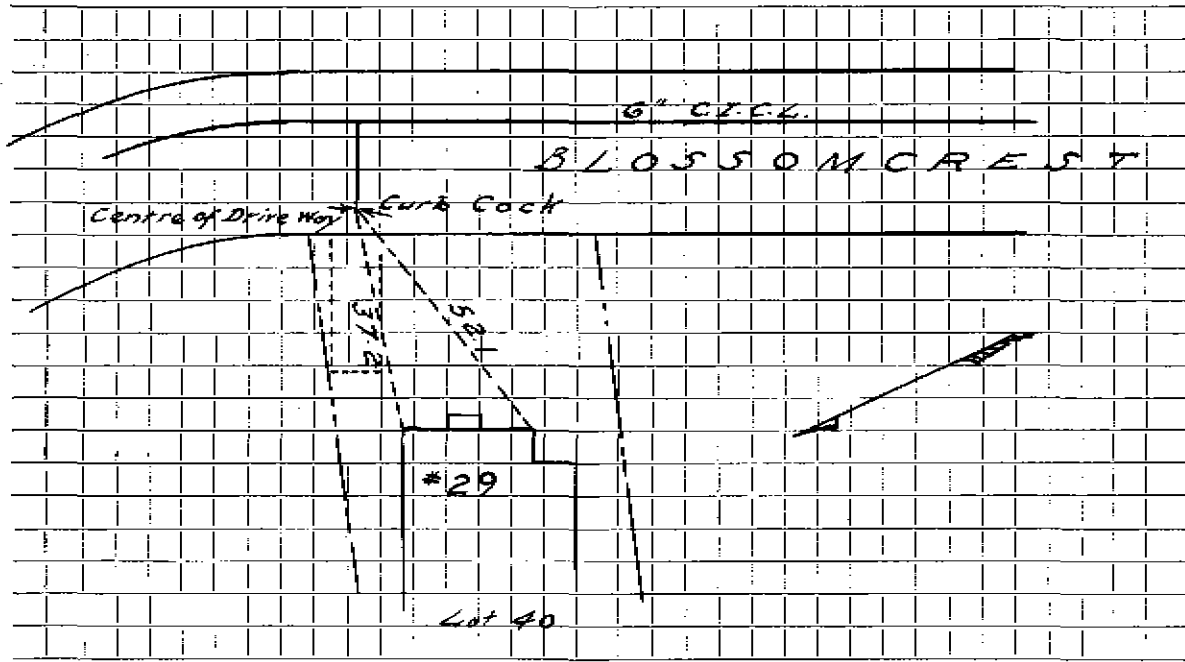

Connection made in \_\_\_\_\_ Street \_\_\_\_\_ Work completed \_\_\_\_\_

Remarks: .....  
.....  
.....