

WATER SERVICE RECORD

Name Richard Spillane

Service No. 111

Address 33 Blossomcrest Road

6836

Location

6942

~~Repairs~~ ~~Reurals~~ - New Service

Comm. 11-19-56


Date	Material	Amount	Total	Date	Amount
5/23/56	Labor	14 40		5-21-56	Deposit 75 00
	10% overhead	1 44	15 84	11-19-56	Refund 1 69
	60' - 3/4" Copper tubing @ .4850	29 10			NON CHARGE 73 31
	1 3/4" Cx 1/2 I.W.H. Stop & Waste	4 96			Labor 2 17
	2 2/3 hrs. Littlefield Shovel	8 50	22 66		10' - 3/4" Copper tubing @ .4850 4 85
	1 hr. trucking		73 31		1 - 3/4 Corp Cock 4 64
					1 - 3/4 Curb Cock 5 94
					1 Box & Rod 4 62
					1 - 1/2 Straight tailpiece 50
					1 - 1/2 Offset tailpiece 50
					1 1/3 hrs. Littlefield Shovel @ 8.50 11 33
					34 55

DATE _____

TOWN OF LEXINGTON — BOARD OF PUBLIC WORKS

WATER DIVISION

Sketch of Service Here

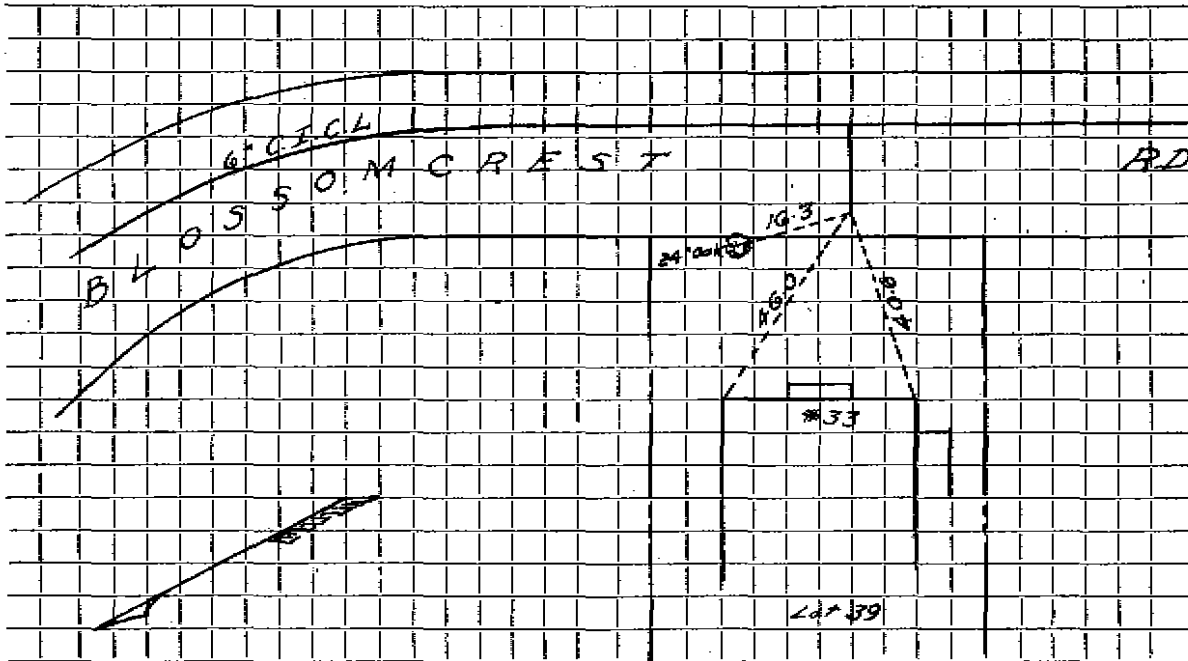

Connection made in Street. Work completed

Remarks:

.....

.....