

WATER SERVICE RECORD

3685

Name John Crosby

Service No. 309

Address 34 Blossomcrest Road

Location

~~Repair - General~~ - New Service

Call 12-31-51


Date	Material	Amount	Total	Date	Amount
12-1-51	Labor	2 87	2 87	11-23-51	Deposited 35 00
	10% Overhead		29	12-31-51	Refunded (7 71
	38'-3/4" Copper Tubing @.320		12 38		27 29
	1-3/4"Cx1/2 I.W.H. S&W		4 00		No Charge
	1 Hr. Littlefield Shovel		7 00	12-1-51	Labor 8 17
	1 Hr. Trucking		75	20'-3/4" Copper Tubing @.320	6 52
	Total		27 29	1-3/4"C Corp Cock	4 33
				1-3/4"Cx3/4"C Curb Cock	4 67
				1-Box & Rd	4 68
				1-1/2 Straight Tail Piece	50
				1-1/2 Offset Tail Piece	50
				2 Hr. Littlefield Shovel @7.00	14 00
				1 Hr. Trucking	75
				Total	44 12

DATE _____

TOWN OF LEXINGTON — BOARD OF PUBLIC WORKS

WATER DIVISION

Sketch of Service Here

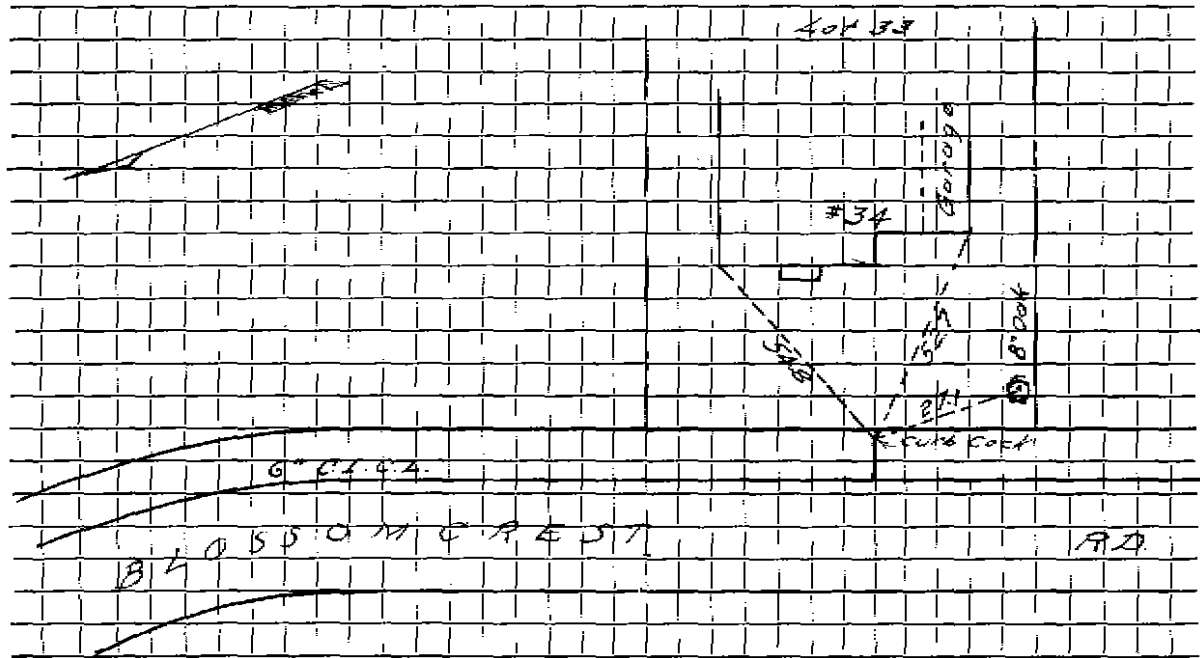

Connection made in _____ Street. Work completed _____

Remarks: _____
