

Name

Address *39 Blossomcrest Road*

39 Blossomcrest Road (Per Eng. 1/11/67)

2872

Location

792 Waltham Street

Kind of Pipe

Size

Size of Main

Repair—Renewal—New Service

Location

Date	Material	Amount	Total	Date	Amount
<u>RELOCATION OF SERVICE</u>					
6-22-66	Labor	89 04			
	10% C.H.	8 90	97 94		
30'	3/4" copper tubing @ .79 (inside)		23 70		
25'	3/4" copper tubing @ .79 (outside)		19 75		
1	3/4" Carb Cock		8 76		
1	3/4" Corp. Cock		7 42		
1	wheel handle		9 30		
1	Yd. Loam		3 00		
1	Lb. grass seed		1 05		
2	Hrs. Trucking @ 3.00		6 00		
1	Hr. Tractor		6 50		
	Labor		183 42		

Handley Press, Inc., Lexington

DATE _____

TOWN OF LEXINGTON—BOARD OF PUBLIC WORKS WATER DIVISION

The undersigned applies for a supply of water at No. _____ St. and hereby agrees to comply with the rules and regulations as now, or at any future time, established by the Board of Selectmen.


Am't. of Estimate \$ _____

Owner J. Berlin

Am't. Paid \$ _____

Address Blossoma Crest
792 Waltham Street

Builder _____

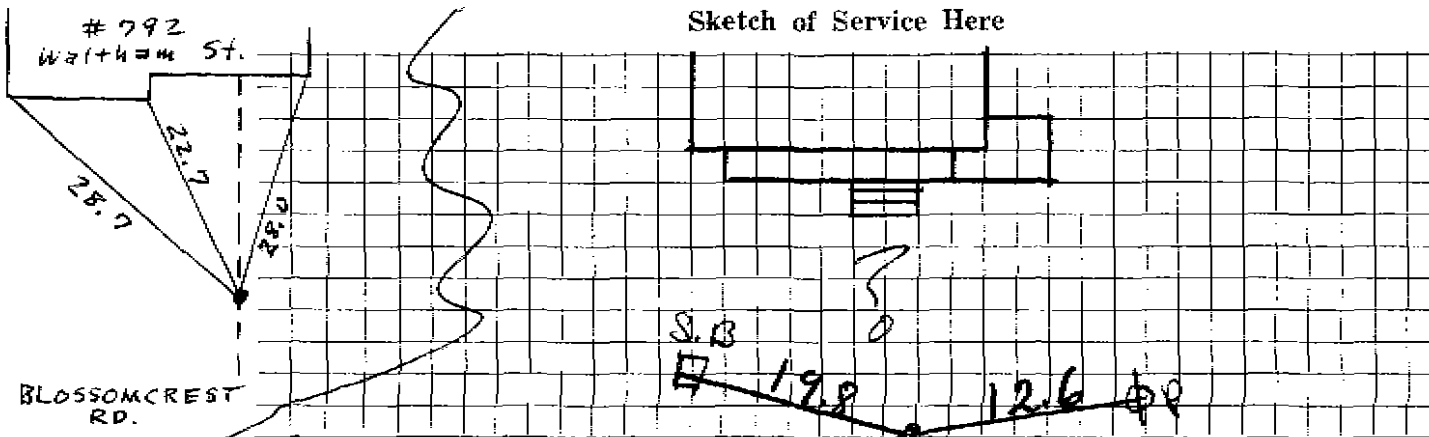

Connection made in Waltham Street. St Work completed _____ 19

Remarks: