

WATER SERVICE RECORD

Name Paul Crosby

Service No. 137

Address 40 Blossomcrest Street

Location

Repair ~~Renewal~~ - New Service

Comm. 10-8-56


Date	Material	Amount	Total	Date	Amount
6/15/56	Labor	19 20		6-5-56	Deposit 125 00
	10% overhead	1 92	21 12	10-8-56	Refund 38 88
	58' 3/4" copper tubing @ .4850		28 13		# 86 12
	1 3/4" Cx 1/2" I.W.H. Stop & Waste		4 96		
	1 hr. Trucking @ .75		75		
	3 2/3 Littlefield @ 8.50		31 16		NON CHARGE
			86 12		
				6/15/56	Labor 5 07
				17' 3/4" coppertubing @ .4850	8 25
				1 3/4" Q Corp. Cock	4 64
				1 3/4" C Curb Cock	5 94
				1 Box & Rod	4 62
				1 1/2 Straight tail Piece	50
				1 1/2 Offset " "	50
				1 hr. Littlefield @ 8.50	8 50
					38 02

DATE _____

TOWN OF LEXINGTON — BOARD OF PUBLIC WORKS

WATER DIVISION

Sketch of Service Here

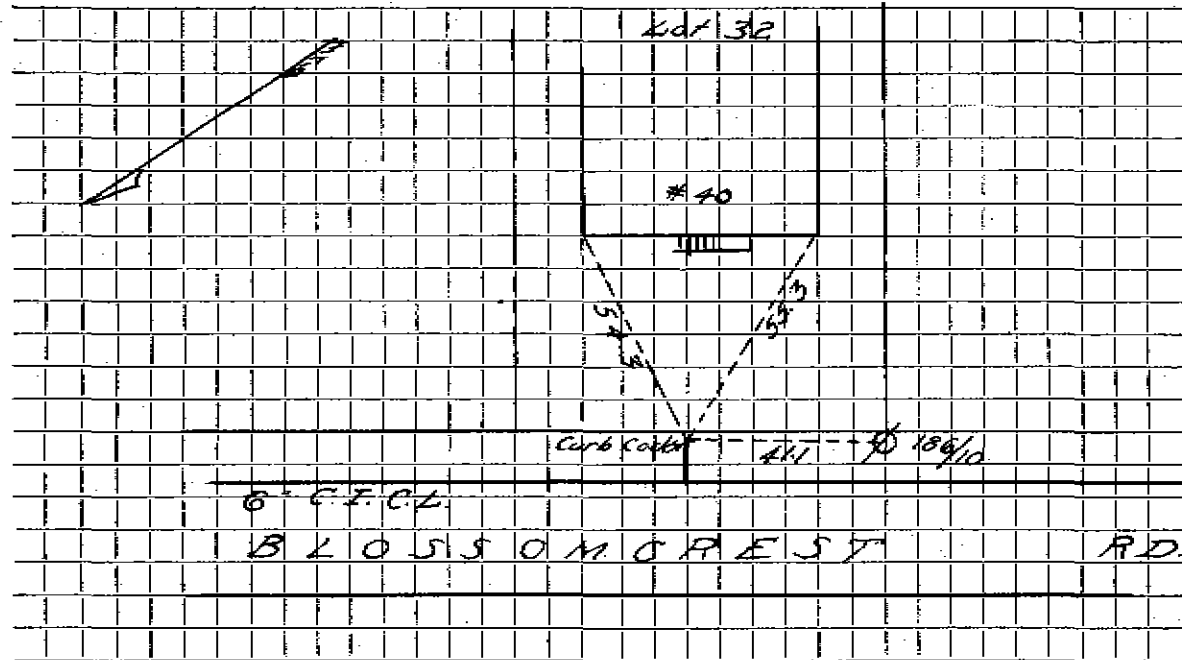

Connection made in Street. Work completed

Remarks:
.....
.....