

WATER SERVICE RECORD

Name A. Clifford Fletcher

Service No. 67

Address 14 Blossomcrest Rd.

Location Lexington

~~Repair~~ ~~Renewal~~ New Service COM. 5-18-53


Date	Material	Amount	Total	Date	Amount
4/21/53	Labor	5 00		4-9-53	40 -
	10% overhead	50	5 50	5-18-53	(9 33)
	38' -3/4" Copper Tubing @.34		12 92		NON-CHARGE 30 67
	1-3/4" C x 1/2 I.W.H. stop & waste	4 00	4 00	4/21/53	Labor 7 50
	1 Hr. Littlefield Shovel		7 50		16' -3/4" Copper tubing @.34 5 44
	1 Hr. Trucking		75		1-3/4" C. Corp-cock 4 33
			30 67		1-3/4" C x 3/4" C. Curb-cock 4 67
					1-Box & Rod 3 90
					1-1/2 straight tail piece 50
					1-1/2 offset tail piece 50
					1 Hr. Littlefield Shovel @7.50 7 50
					1 Hr. Trucking 75
					35 09

DATE \_\_\_\_\_

TOWN OF LEXINGTON — BOARD OF PUBLIC WORKS

WATER DIVISION

Sketch of Service Here

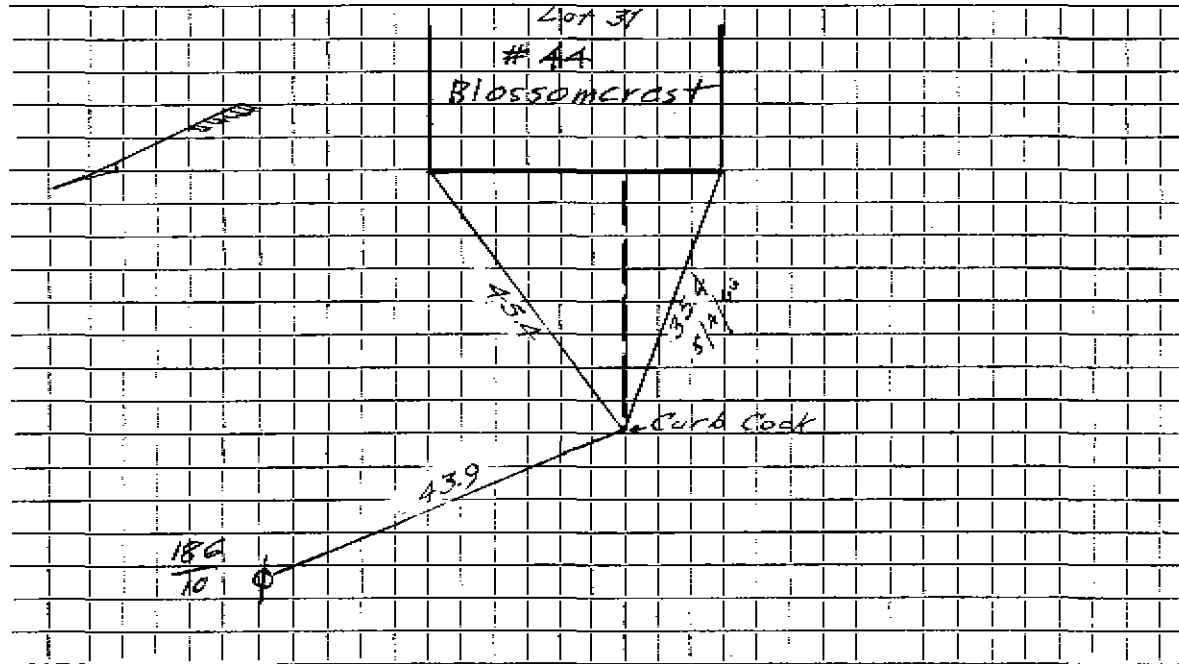

Connection made in ..... Street. Work completed .....

Remarks: .....  
.....  
.....