


DATE 10/24/19

TOWN OF LEXINGTON -- BOARD OF PUBLIC WORKS

WATER DIVISION

Sketch of Service Here

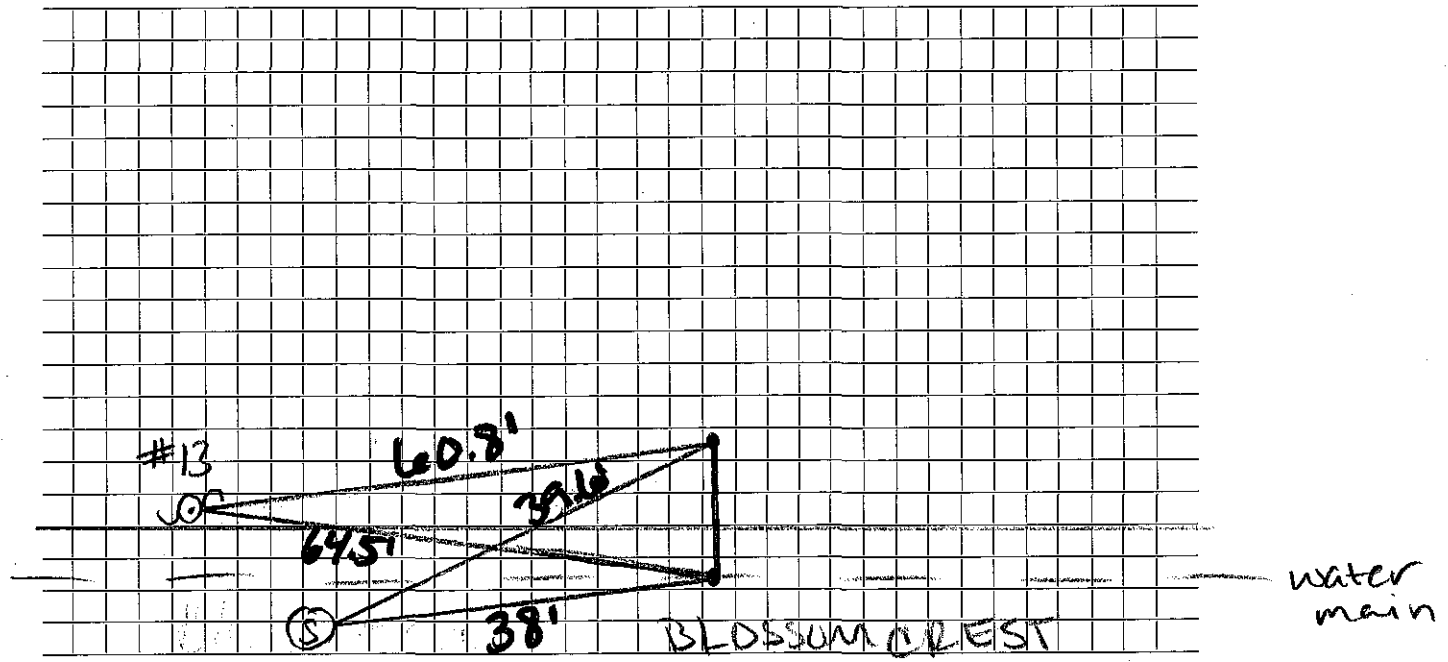

Connection made in... Blossum Crest Street. Work completed

Remarks: