


DATE 9/29/89

TOWN OF LEXINGTON — BOARD OF PUBLIC WORKS
WATER DIVISION

Sketch of Service Here

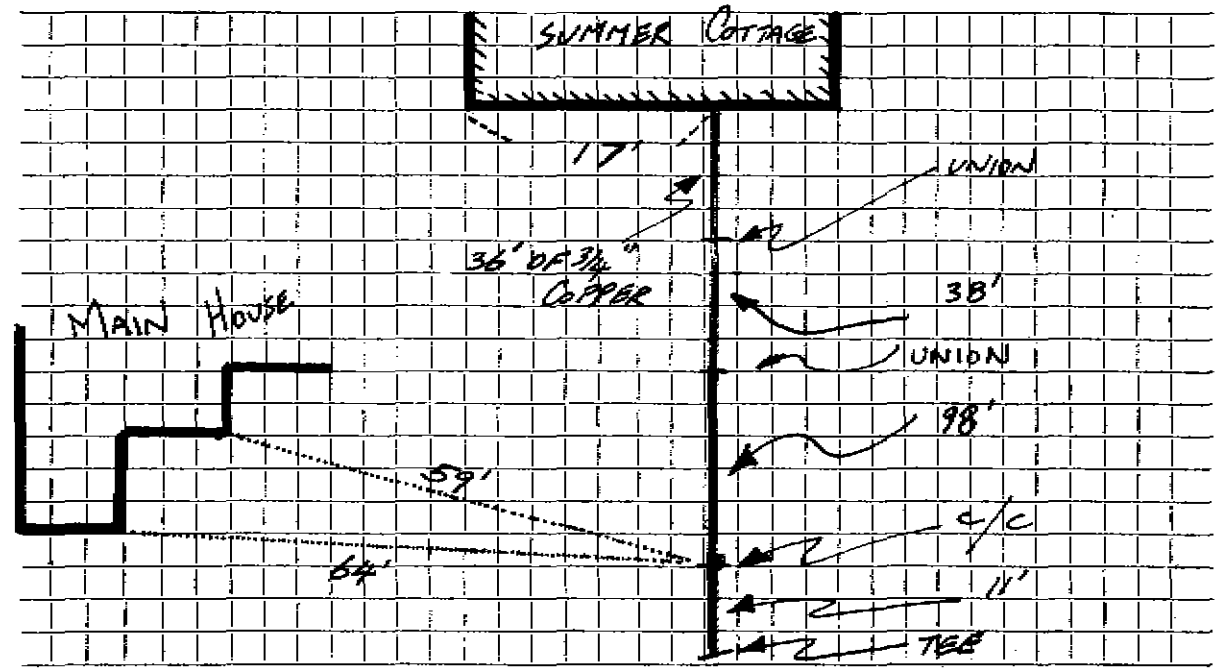

Connection made in Street. Work completed

Remarks: INSPECTED: MB


DATE 9-29-89

TOWN OF LEXINGTON — BOARD OF PUBLIC WORKS

WATER DIVISION

#56 BLOSSOM CREST ROAD

Sketch of Service Here

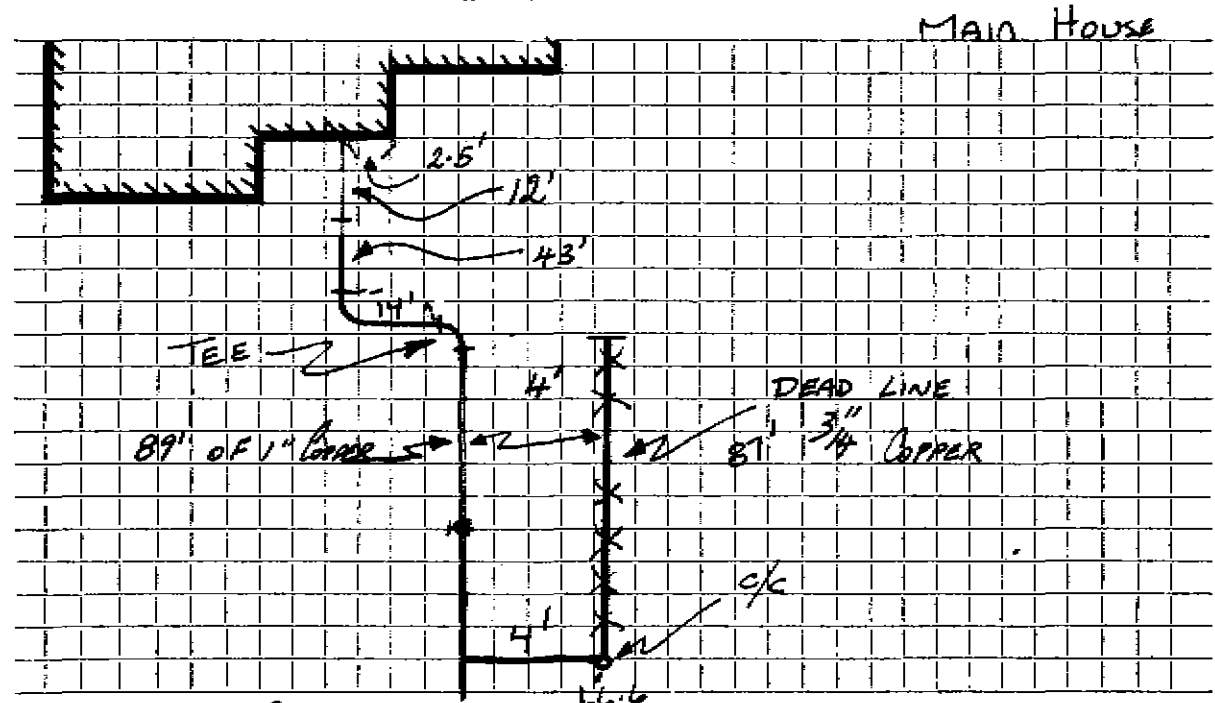

Connection made in BLOSSOM CREST Rd. Street. Work completed

Remarks: