

WATER SERVICE RECORD

Name Michael Graziano

Service No. 62

Address ~~1111 Blossomcrest Road~~ 57 Blossomcrest Road (Per Eng. 10-18-66)

4666

Location

Repair—Renewal—New Service

Comm 6-1-59


Date	Material	Amount	Total	Date	Material	Amount
4-24-59	Labor	23 99		4-17-59	Deposit	100 00
	10% O. H.	2 40	26 39	6-1-59	Retard	26 77
37'	3/4" Copper Tubing @.3666		13 56			73 29
1	3/4" Cx 1/2 I.W.H. Stop & Waste		5 84		NON CHARGE	
2	Hrs. Town Shovel @6.50		13 00	1-24-59	Labor	14 26
2	Hrs. Trucking @.75		1 50	22'	3/4" Copper Tubing @.	8 07
	13 x 3 Patch		13 00	1	3/4" C Corp Cock	4 64
			73 29	1	3/4" C Curb Cock	6 03
				1	Box & Rod	5 00
				1	1/2 Straight Tailpiece	50
				1	1/2 Offset Tailpiece	50
				1	Hr. Town Shovel @6.50	6 50
						45 50

TOWN OF LEXINGTON — BOARD OF PUBLIC WORKS

WATER DIVISION

DATE _____

Sketch of Service Here

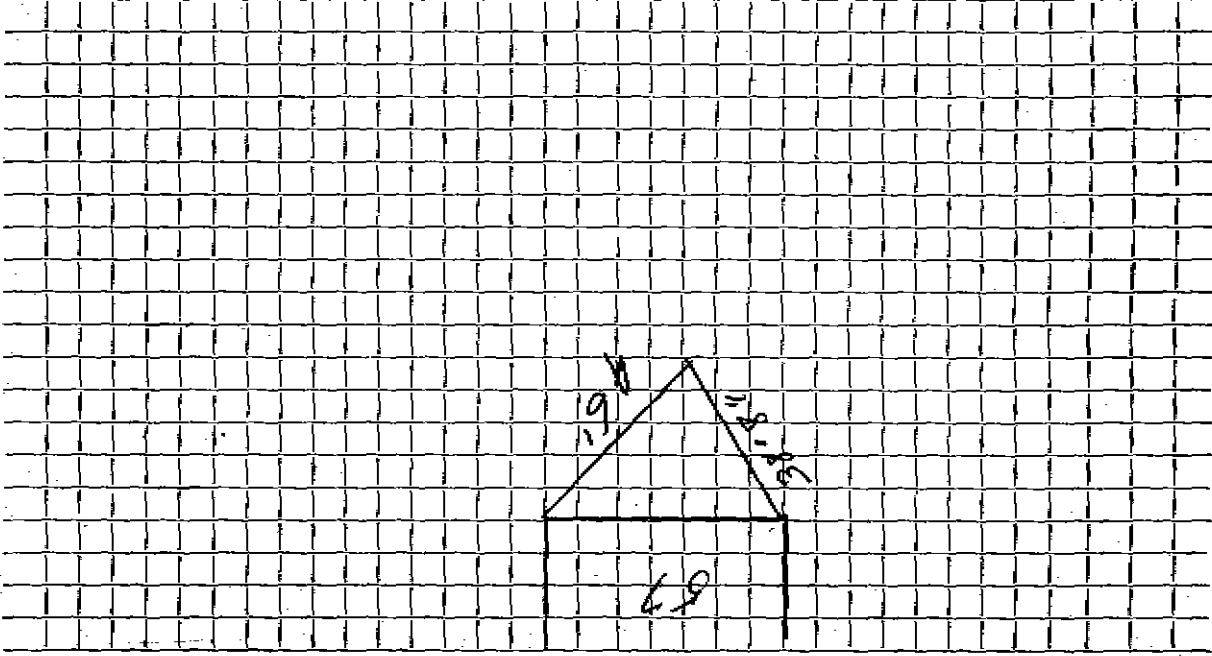

Connection made in _____

Street _____

Work completed _____

Remarks: _____

