

WATER SERVICE RECORD

Name Michael Graziano

Service No. 63

Address ~~63 Blossomcrest Road~~ 63 Blossomcrest Road (Per Eng. 10-18-66)

439

Location

~~Repair~~ New Service

Comm 6-1-59


Date	Material	Amount	Total	Date		Amount
4-27-59	Labor	34.82		4-17-59	Deposit	100.00
	10% O.H.	3.48	38.30	6-1-59	Retund.	12.00
46'	3/4" Copper tubing @.3666		16.86			88.00
1	3/4" C x 1/2 I.W.H. Stop & Waste	5.84			NON CHARGE	
3	hrs. Pippin Backhoe @4.50		13.50		Labor	10.60
2	hrs. Trucking @.75		1.50	14'	3/4" Copper tubing @.3666	5.13
12	x 3 Patch		12.00	1	3/4" C Corp Cock	4.64
			88.00	1	3/4" C Gurb Cock	6.03
				1	Box & Rod	5.00
				1	1/2 Straight tailpiece	.50
				1	1/2 Offset tailpiece	.50
				1	hr. Pippin Backhoe @4.50	4.50
						36.90

TOWN OF LEXINGTON — BOARD OF PUBLIC WORKS

WATER DIVISION

DATE _____

Sketch of Service Here

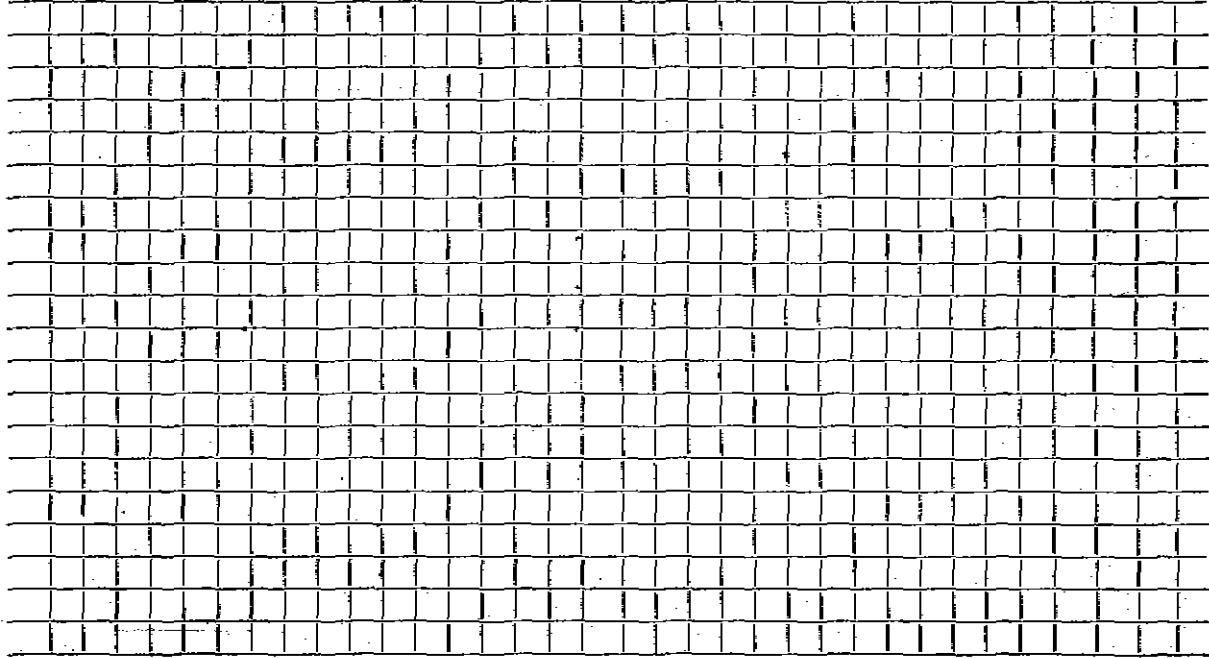

Street. Work completed

Connection made in

Remarks: