




DATE 9-17-01

TOWN OF LEXINGTON — BOARD OF PUBLIC WORKS  
WATER DIVISION

Sketch of Service Here

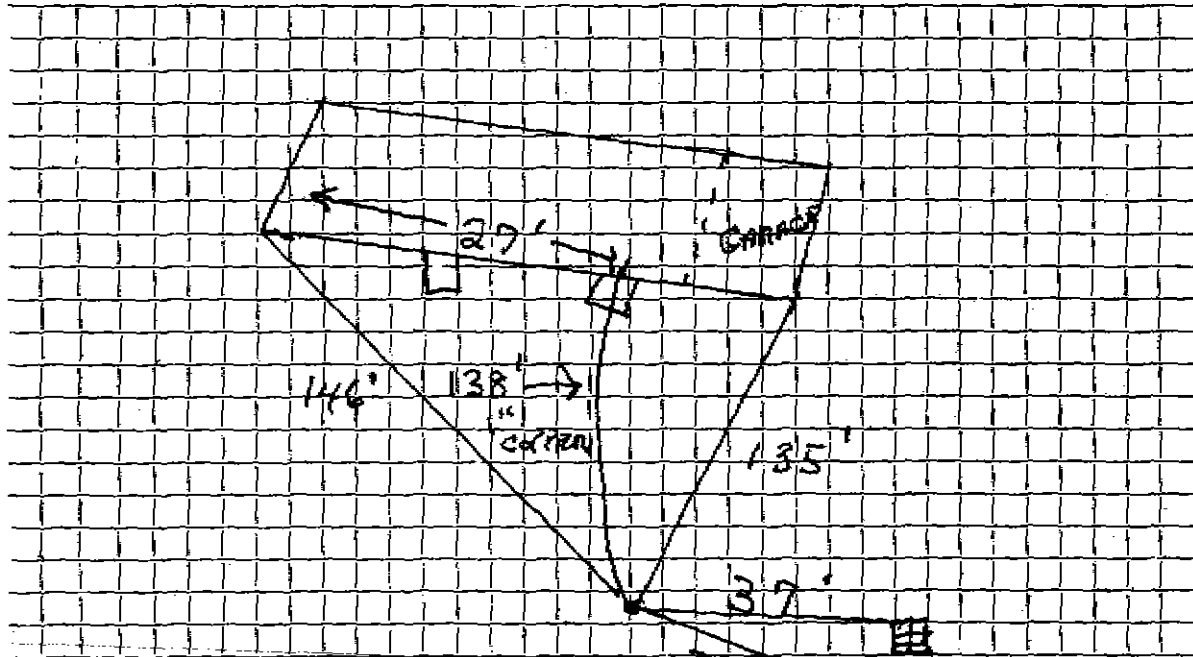

Connection made in BLOSSOM CREST Street.

32' OSMH  
Work completed

Remarks: FX INSTALLED BY J. McLAUGHLIN