


DATE DEC 12 1998

TOWN OF LEXINGTON — BOARD OF PUBLIC WORKS

WATER DIVISION

Sketch of Service Here

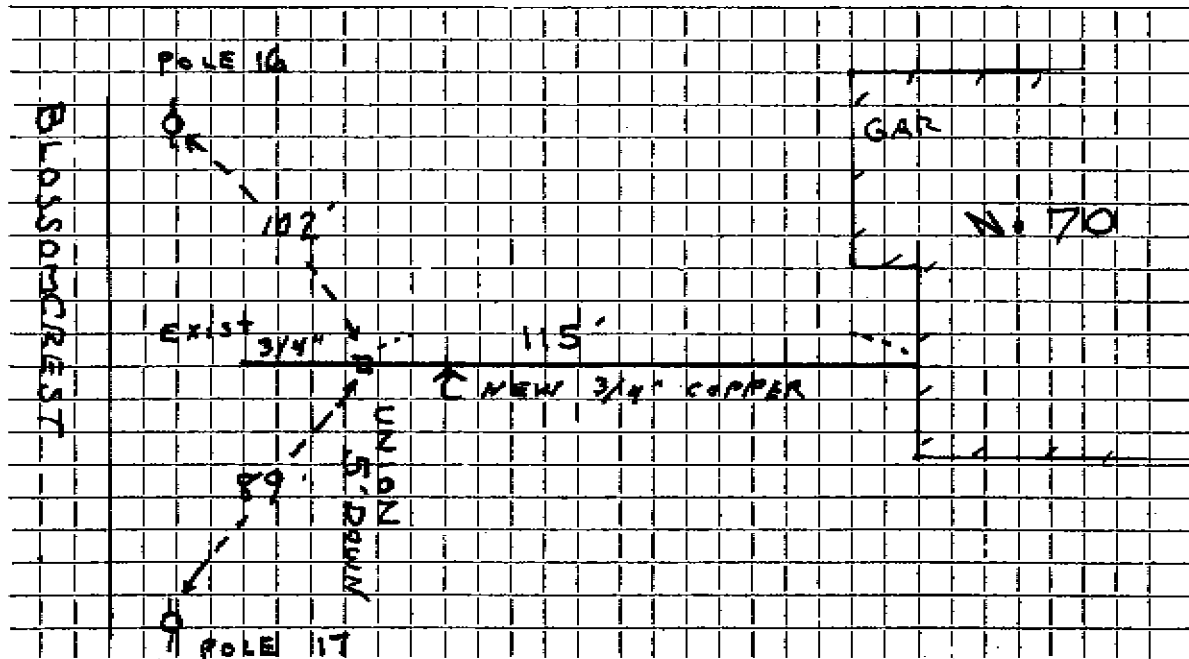

Connection made in BLOSSOMCREST Street.

Work completed C. MINA. CONST.

Remarks:

FIELD BOOK 97-5

T.A.M.

Name George T. Still

Service No. 109 #2745

Address ~~70 Blossom Street~~

70 Blossomcrest Road (Per Eng. 10-18-66)

Lexington, Mass

Location 70 ~~Blossom~~ Street

Kind of Pipe

Size

Size of Main

Repair—~~Renovate~~ ~~Flow Service~~

Com. 7-3-50

Location

Date	Material	Amount	Total	Date	Amount
June 16, '50	Labor	2 65	2 65	May 25 '50	100 00
	10% Overhead		27	July 20 '50	60 00
	85' - 3/4" Copper Tubing @ .23	19 55	19 55		30 51
	1 - 3/4" E x 1/2" I.W.H. S&W	3 29	3 29	June 16, '50	2 65
	Trucking 1 hr. @ .75	75	75	10' - 3/4" Copper Tubing @ .23	2 30
	Patching 4 x 3	4 00	4 00	1 - 3/4" C Corp-cock	3 15
			30 51	1 - 3/4" C x 3/4" C Gurb-cock	3 85
				1 - Box & Rod	3 35
				1 - 1" Straight Tail Piece	38
				1 - 1" Offset Tail Piece	38
				Littlefield Shovel 2 hrs. @ 7.00	14 00
				Trucking 1 hr. @ .75	75
	Labor				30 81

Reported
Referenced
No Charge

DATE _____

TOWN OF LEXINGTON - BOARD OF PUBLIC WORKS

WATER DIVISION

The undersigned applies for a supply of water at No..... St. and hereby agrees to comply with the rules and regulations as now, or at any future time, established by the Board of Selectmen.

Am't of Estimate \$.....

Owner


Am't Paid \$.....

Address

Builder

.....

Sketch of Service Here

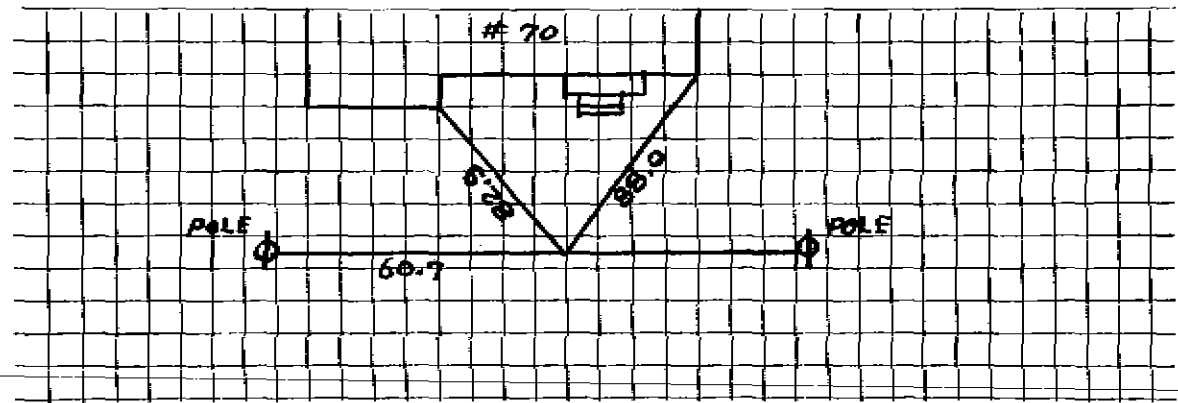

Connection made in Street.

Work completed19

Remarks: