

Name Philip Spencer

Service No. 156

Address ~~74 Blossom Street~~

74 Blossomcrest Road (Per Eng. 10-18-66)

Lexington

Location 74 ~~Blossom~~ Street

Kind of Pipe

Size

Size of Main

~~Repair - Honorary~~ - New Service

Com. 9-5-50

Location

Date	Material	Amount	Total	Date	Location	Amount
July 10'50	Labor	4 45		July 5'50	Reported	70 00
	10% Overhead	45	4 90			10 00
	83' - 3/4" Copper Tubing @ 23¢		19 09			53 42
	1 - 3/4"C x 1/2" L.W.H. S&W		3 29		No Charge	
	1 - 3/4"C x 3/4"C Union (3 pts)		1 39	July 10'50	Labor	4 53
	3 hrs. Littlefield Shovel		21 00		10' - 3/4" Copper Tubing @ 23¢	2 30
	1 hr. Trucking		75		1 - 3/4"C Corp-cock	3 15
	Patching 3 x 3		3 00		1 - 3/4"C x 3/4"C Curb-cock	3 85
			53 42		1 Box & Rod	3 35
					1 - 1/2" Offset Tail Piece	38
					1 - 1/2" Straight Tail Piece	38
					1 hr. Littlefield Shovel	7 00
					1 hr. Trucking	75
	Labor					25 69

DATE _____

TOWN OF LEXINGTON—BOARD OF PUBLIC WORKS

WATER DIVISION

The undersigned applies for a supply of water at No. _____ St. and hereby agrees to comply with the rules and regulations as now, or at any future time, established by the Board of Selectmen.

Am't. of Estimate \$ _____


Owner _____

Am't. Paid \$ _____

Address _____

Builder _____

Sketch of Service Here

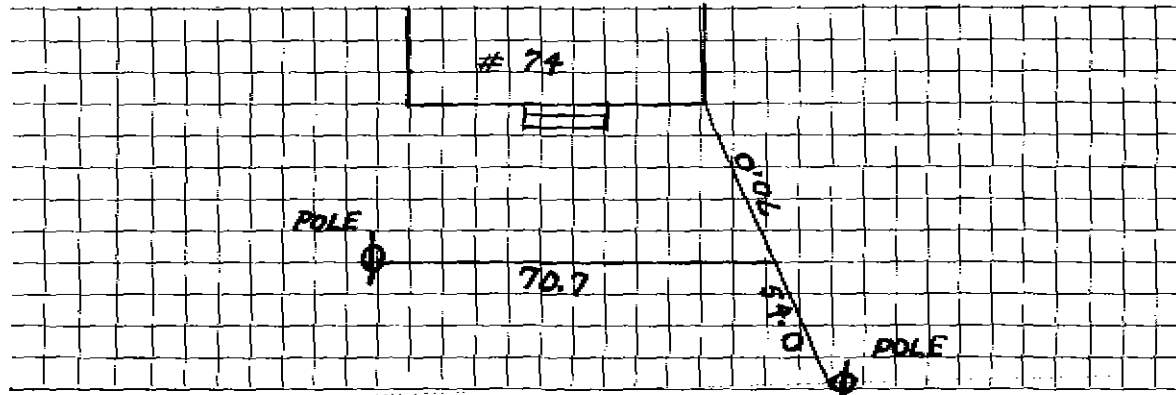

Connection made in _____ Street.

Work completed _____ 19

Remarks: