


DATE NOV. 1967

TOWN OF LEXINGTON — BOARD OF PUBLIC WORKS
WATER DIVISION

Sketch of Service Here

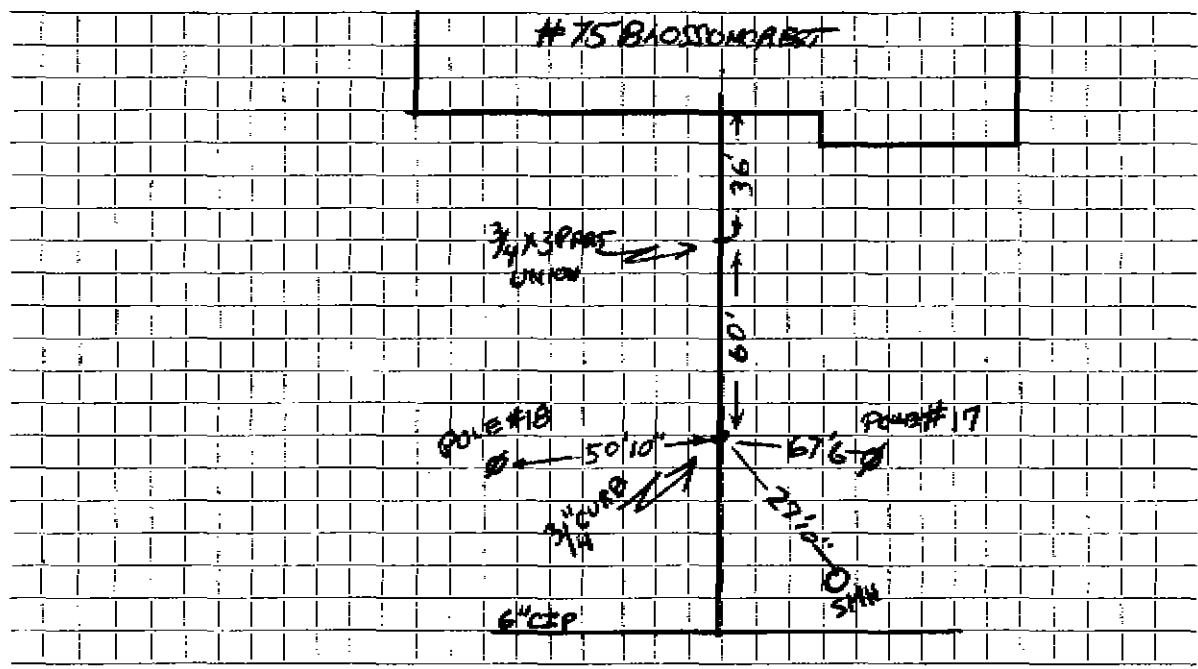

Connection made in BLOSSOM AVE. RO. Street. Work completed JUNE 1966

Remarks:

.....

.....