




DATE 9-26-2001

TOWN OF LEXINGTON — BOARD OF PUBLIC WORKS

WATER DIVISION

GARAGE  
Sketch of Service Here

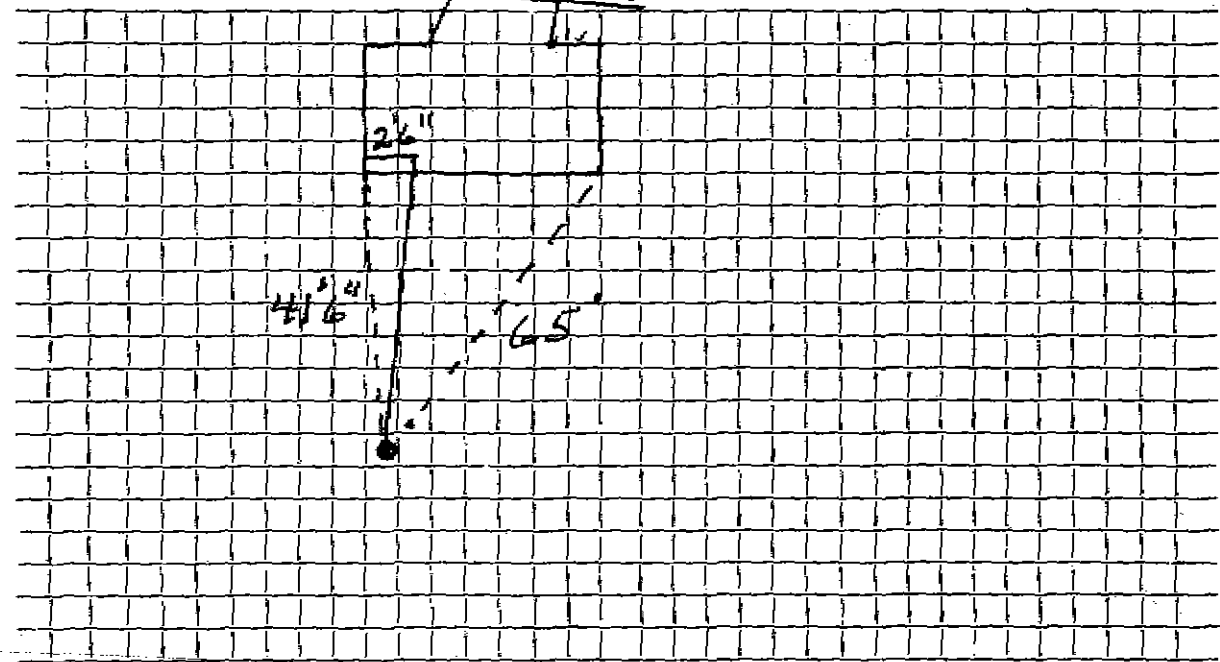

Connection made in BLOSSOMCREST..... Street. Work completed .....

Remarks: INSTALLED BY J. McLAUGHLIN.....