

WATER SERVICE RECORD

Name William E. Spinney

Service No. 102

Address ~~XXXXXXXXXXXX~~ 87 Blossomcrest Road ( Per Eng. 10-18-66)

Location

~~Special Renewal - XXXXXXXX~~ W.O. #1012


MAR 14 1966

Date	Material	Amount	Total	Date	Amount
9-28-65	Labor	94.39			
9-29-65	"	58.32	152.71		
	10% O.H.	15.27	167.98		
	140' 3/4" Copper tubing @.42		58.80		CURB TO MAIN
1	Adapter		2.76	27'	3/4" Copper tubing @.42 11.34
1	Wheel Haddle		9.29	28	ton gravel 1.10 30.80
2	Unions @3.01		6.02	18	yds. Loam @3.00 54.00
	14 x 3 Patch		14.00	1	Curb Cock 8.76
6	hrs Town Truck @3.00		18.00	1	Box & Rod 4.09
2	hrs. Dozer @4.00		8.00		108.99
2	hrs. Shovel @6.50		13.00		
1	hr. Loader @4.00		4.00		
			301.35		

DATE \_\_\_\_\_

**TOWN OF LEXINGTON — BOARD OF PUBLIC WORKS**  
**WATER DIVISION**

Sketch of Service Here

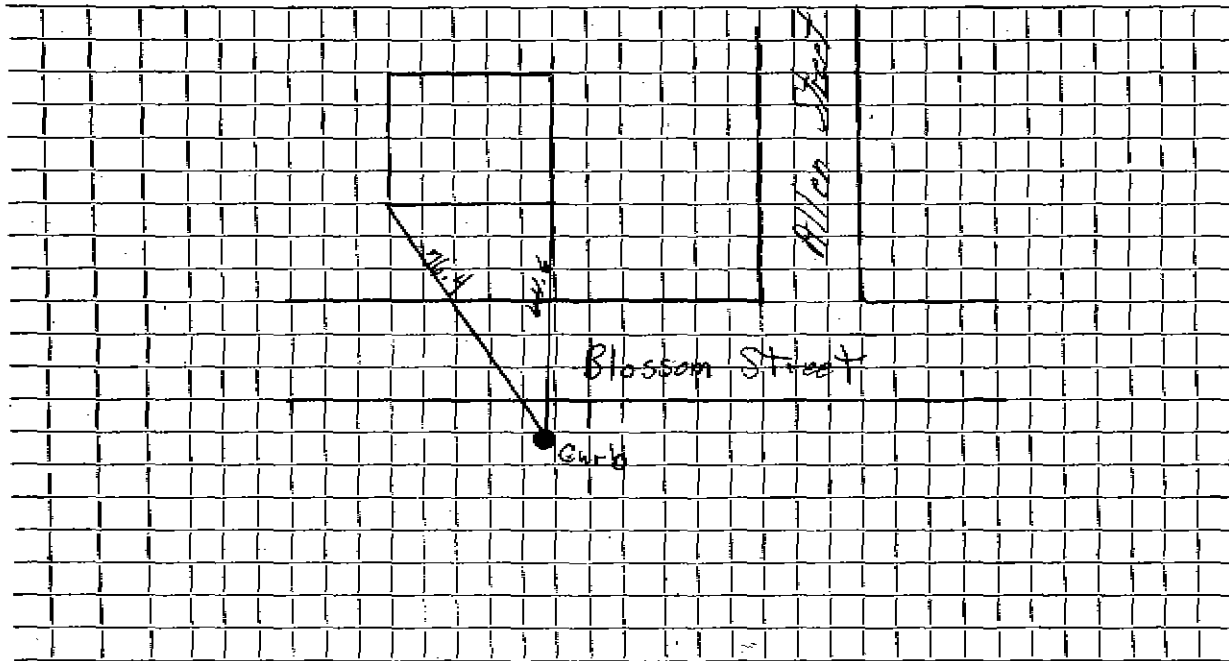

Connection made in ..... Street. Work completed .....

Remarks: .....  
.....  
.....