

WATER SERVICE RECORD

Name **Elvin G. Boyden**

Service No. **82**

Address ~~75 BLOSSOMCREST~~ **95 Blossomcrest Road (Per Eng. 10-18-66)**

7273

Location

7493

~~Service Record~~ **New Service W.O. # 8129**


Comm 10-28-63

Date	Material	Amount	Total	Date		Amount
9-4-63	Labor	8 28		9-21-63	Deposit	150 00
	10% O.H.	83	9.11	11-28-63	Refund	103 04
6'	3/4" Copper tubing @.42		2.52			46 96
1	3/4" CX 1/2 I.W.H. Stop & Waste		6.17			
1	3/4" C3 Part Union		2.41		NON CHARGE	
1 1/4	X 3 Patch		14.00	9-4-63	Labor	30 36
1 1/2	Hrs. Town Shovel @6.50		9.75	22'	3/4" Copper tubing @.42	9 24
1	Hr. Trucking @3.00		3.00	1	3/4" C Corp Cook	4 91
			46.96	1	3/4" C Curb Cook	6 28
				1	Box & Rod	4 90
				1	1/2 Straight tailpiece	50
10/22/63	Labor	2 42		1	1/2 Offset tailpiece	50
	10% Overhead	84	2 66			
	5' 3/4" copper tubing @ .42		2 10			56 69
	1 3/4" C 3 part union		2 41			
	1 Hr. Trucking @ 3.00		3 00			
			10 17			

DATE _____

TOWN OF LEXINGTON — BOARD OF PUBLIC WORKS
WATER DIVISION

Sketch of Service Here

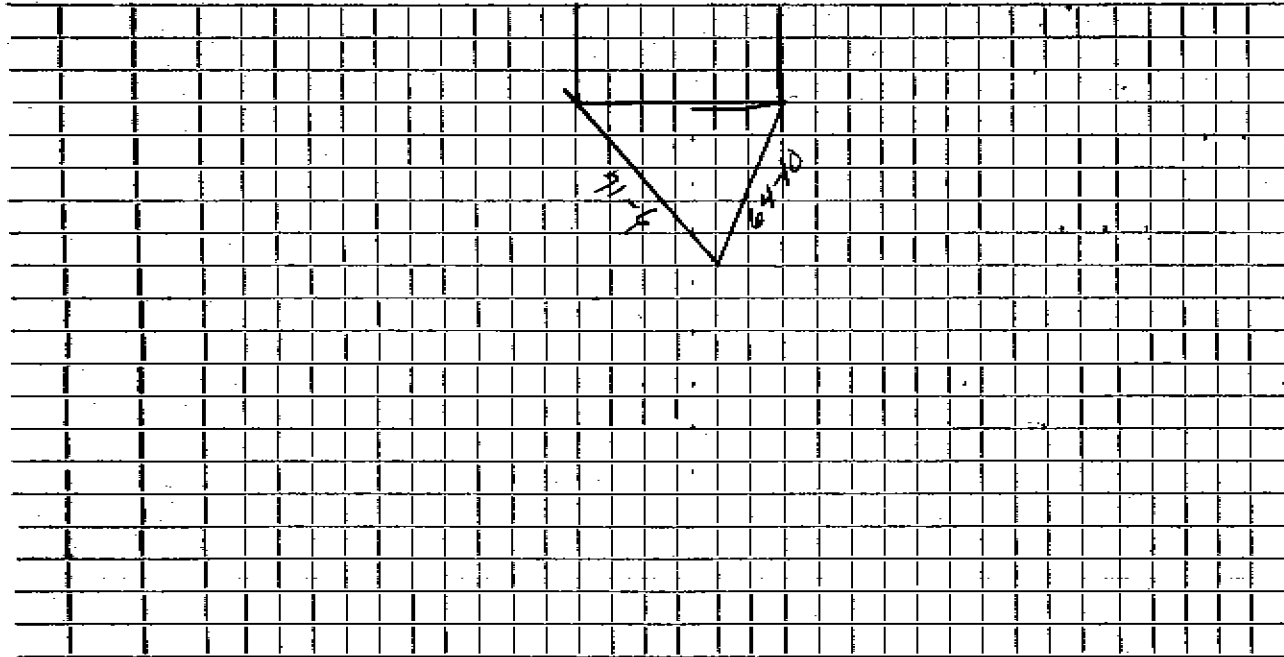

Connection made in _____ Street _____ Work completed _____

Remarks: _____

