

WATER SERVICE RECORD

Name Donald Leone

Service No. 62

Address 98 Blossomcrest Road

Location

~~REPAIR/RENEWAL~~—New Service W.O. #3870 DeFelice #2934


MAR 15 1976

Date	Material	Amount	Total	Date	Amount	
12/11/75	Labor	57.72		12-9-75	Deposit	150.00
	10% O.H.	5.77	63.49	7-11-76	Yuni	2.36
37'	3/4" Copper tubing @.67		24.79			152.26
1	3/4" Curb Cock		13.70			
1	3/4" Corporation		10.53			
1	Box & Road		15.40			
1/2	ton Cold Patch		6.85			
1 1/2	hr. Trucking @3.00		4.50			
2	hrs. Town Shovel @6.50		13.00			
			152.26			
12/17/75	56' 3/4" Copper tubing					

DATE _____

TOWN OF LEXINGTON — BOARD OF PUBLIC WORKS
WATER DIVISION

Sketch of Service Here

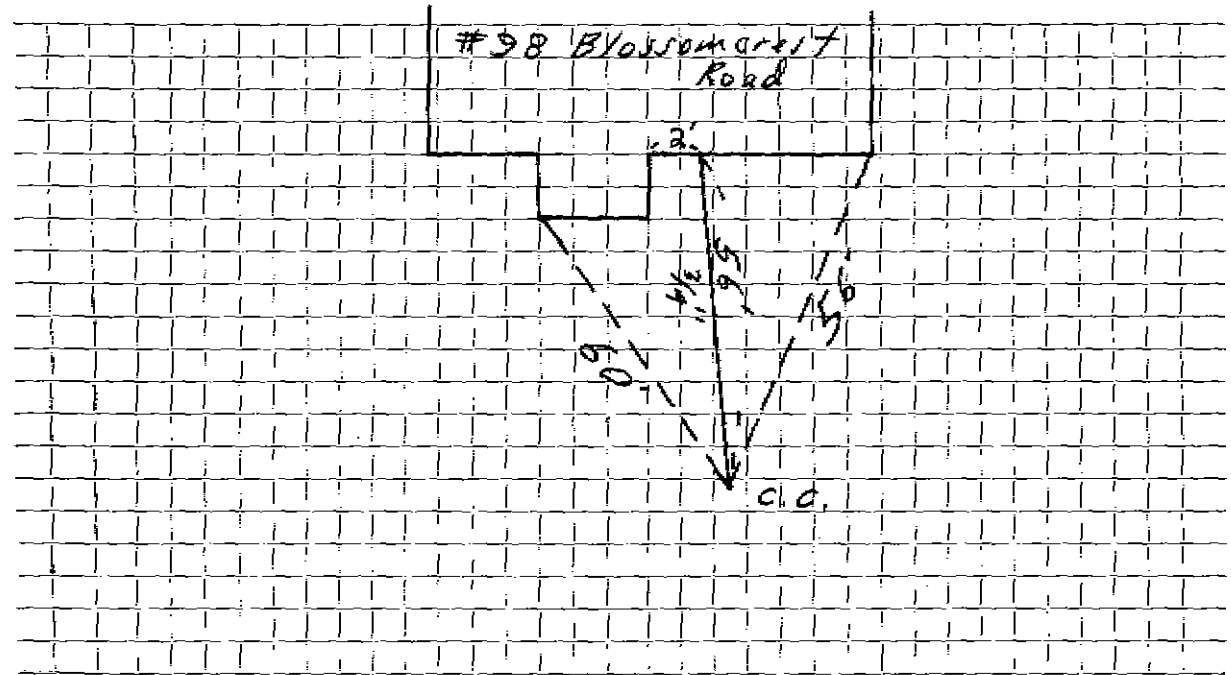

Connection made in Street. Work completed

Remarks:
.....
.....