

WATER SERVICE RECORD

Service No. 148 (1956)

Name DeVries Construction

Address 10 Blueberry Lane

Location


~~Repair - Renewal~~ - New Service

Comm. 9/30/57

Date	Material	Amount	Total	Date	Amount
7/8/57	Labor	1 95		6-8-56	Deposit \$ 50 00
	10% overhead	20	2 15	9-30-57	Refund 29 39
	34' - 3/4" Copper tubing @ .375	12 75			NON CHARGE \$ 20 61
	1 - 3/4" Cx $\frac{1}{2}$ I.W.H. Stop & Waste	4 96		7/8/57	Labor 1 95
	1 hr. Trucking		75	27' - 3/4" Copper tubing @ .375	10 13
			20 61	1 - 3/4" C. Corp Cock	4 64
				1 - 3/4" C. Curb Cock	5 94
				1 Box & Rod	4 62
				1 - $\frac{1}{2}$ Straight tailpiece	50
				1 - $\frac{1}{2}$ Offset tailpiece	50
					28 28

TOWN OF LEXINGTON — BOARD OF PUBLIC WORKS
WATER DIVISION

Sketch of Service Here

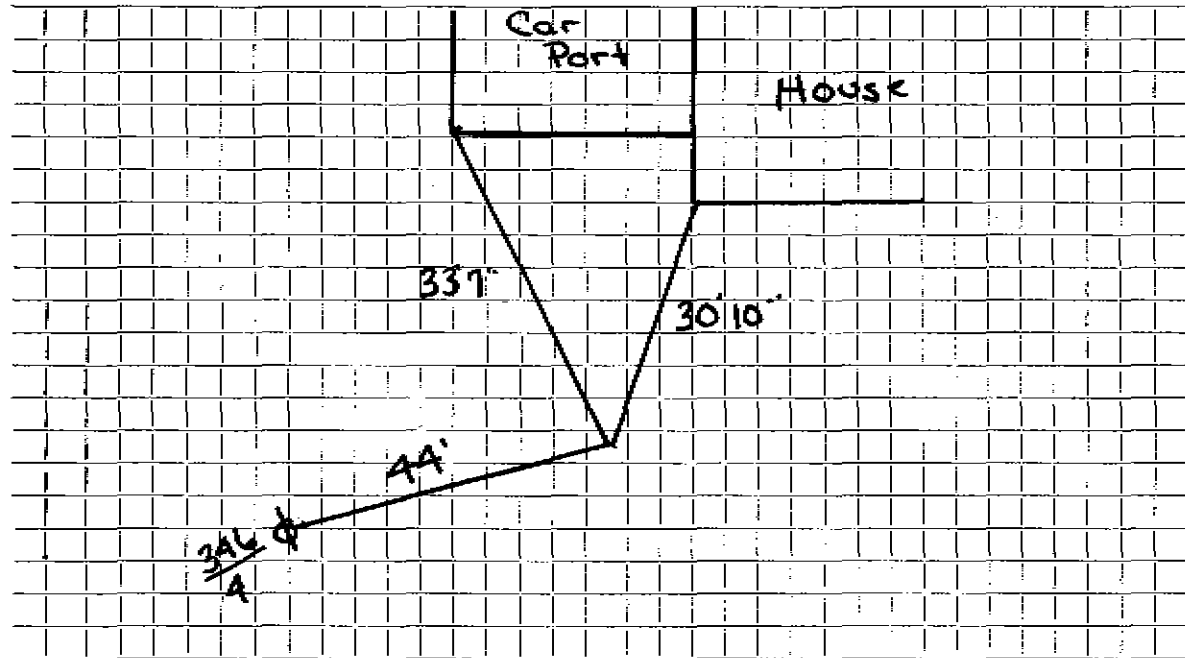

Connection made in Street. Work completed

Remarks:
.....
.....