

## WATER SERVICE RECORD

Name DeVries Construction Company

Service No. 151 (1956)

Address 14 Blueberry Lane

#57147

Location

~~Repair - Renewal~~ - New Service


Comm. 9/30/57

Date	Material	Amount	Total	Date	Amount	
7/8/57	Labor	1 95		6-8-56	Deposit	\$ 50 00
	10% overhead	20	2 15	9-30-57	Refund	27 89
	38' - 3/4" Copper tubing @ .375	14 25			NON CHARGE	\$ 22 11
	1 - 3/4" Cx 1/2 I.W.H. Stop & Waste	4 96	7 81	7/8/57	Labor	1 95
	1 hr. Trucking		75	27/8-3/4" Copper tubing @ .375		10 13
			22 11	1 - 3/4" C. Corp Cock		4 64
				1 - 3/4" C. Curb Cock		5 94
				1 Box & Rod		4 62
				1 - 1/2 Straight tailpiece		50
				1 - 1/2 Offset tailpiece		50
						28 28

DATE \_\_\_\_\_

TOWN OF LEXINGTON — BOARD OF PUBLIC WORKS  
WATER DIVISION

Sketch of Service Here

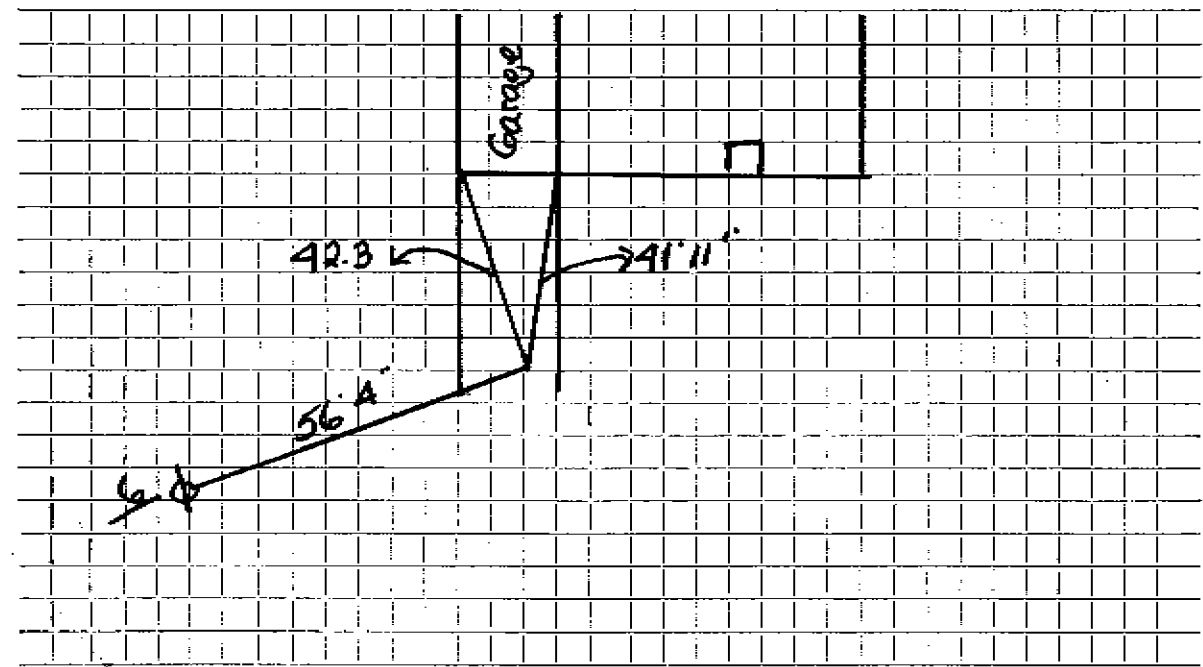

Connection made in ..... Street. Work completed .....

Remarks: .....  
.....  
.....