

WATER SERVICE RECORD

Name DeVries Construction Company

Service No. 152

Address 15 Blueberry Lane

Location _____

Repair—Renewal—New Service _____


Comm 9-24-54

Date	Material	Amount	Total	Date	Amount
6/13/56	Labor	1 95		6-8-56	Deposit \$ 50 00
	10% overhead	20	2 15	9-24-56	Refund \$ 17 89
	50' 3/4" copper tubing @ .4850		24 25		<u>NON CHARGES</u> 32 11
	1 3/4" C x 1/2" I.W.H. stop&waste		4 96	Labor	1 95
	1 hr. trucking @ .75		75	50' 3/4" copper tubing @ .4850	3 40
			32 11	1 3/4" C Corp Cock	4 34
				1 3/4" C Curb Cock	5 94
				1 Box & Rod	4 62
				1 1/2 Straight tail piece	50
				1 1/2 Offset tail piece	50
					21 25
				<i>\$ 7.86 applied to W.H.#291</i>	
				<i>7.86 " " #292</i>	

DATE _____

TOWN OF LEXINGTON — BOARD OF PUBLIC WORKS
WATER DIVISION

Sketch of Service Here

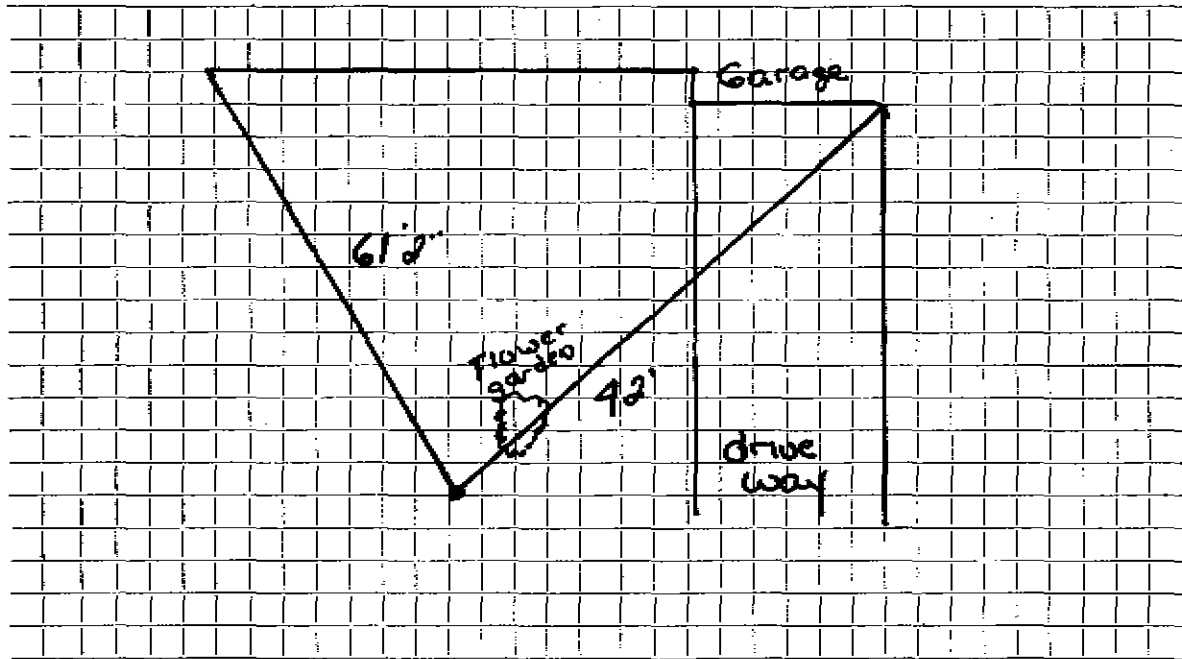

Connection made in Street. Work completed

Remarks:
.....
.....