

WATER SERVICE RECORD

Name DeVries Construction Company

Service No. 153 (1956)

Address 16 Blueberry Lane

Location


~~Repair & Renewal~~ - New Service

Comm. 9/30/57

| Date | Material | Amount | Total | Date | Amount |
|--------|-------------------------------------|--------|-------|---------------------------------|---------------------|
| 7/8/57 | Labor | 1 95 | | 6-8-57 | Deposit \$ 50 00 |
| | 10% overhead | 20 | 2 15 | 9-30-57 | Refund 21 89 |
| | 54' - 3/4" Copper tubing @ .375 | 20 25 | | | NON CHARGE \$ 28 11 |
| | 1 - 3/4" Cx 1/2 I.W.H. Stop & Waste | 4 96 | | 7/8/57 | Labor 1 95 |
| | 1 hr. Trucking | | 75 | 27' - 3/4" Copper tubing @ .375 | 10 13 |
| | | | 28 11 | 1 - 3/4" G. Corp Cock | 4 64 |
| | | | | 1 - 3/4" G. Curb Cock | 5 94 |
| | | | | 1 Box & Rod | 4 62 |
| | | | | 1 - 1/2" Straight tailpiece | 50 |
| | | | | 1 - 1/2" Offset tailpiece | 50 |
| | | | | | 28 28 |

TOWN OF LEXINGTON — BOARD OF PUBLIC WORKS
WATER DIVISION

Sketch of Service Here

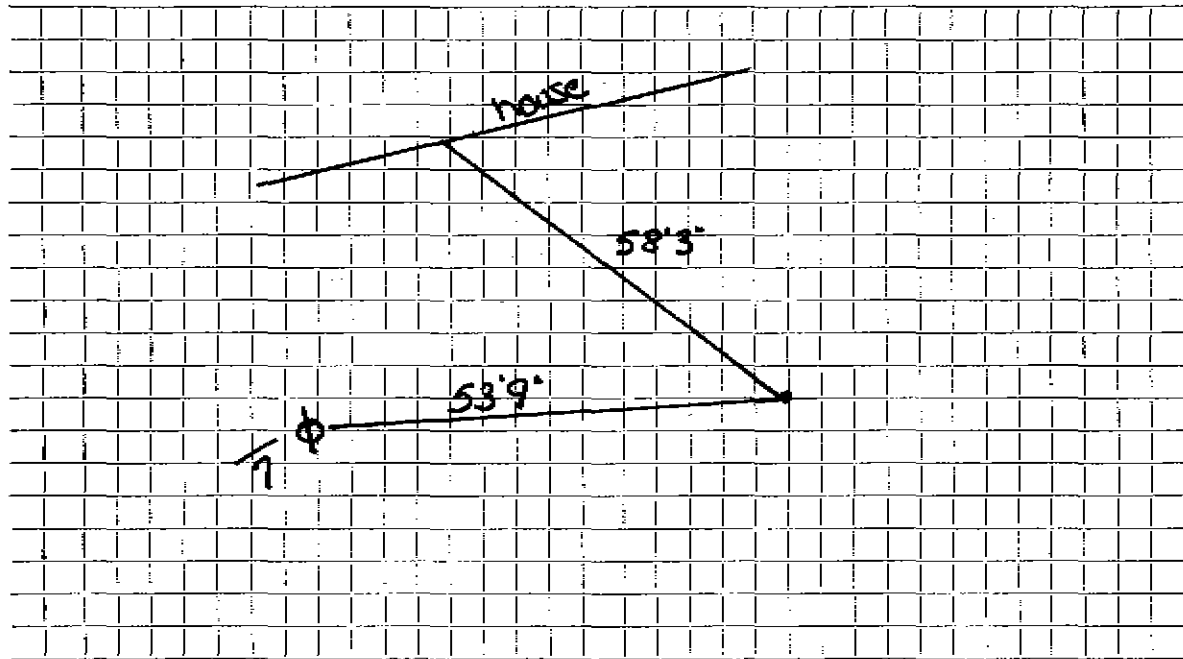

Connection made in Street. Work completed

Remarks:
.....
.....