

**WATER SERVICE RECORD**

Service No. 267 N.D.

Name Devries Construction Company

Address 19 Blueberry Lane

Location

#7157

~~REPAIR~~ ~~REPAIR~~ - New Service


Comm 9-24-56

Date	Material	Amount	Total	Date	Amount
6/16/56	Labor	1 95		9-24-56	Paid by Refers W.H. #147 \$ 7 86
	10% overhead	20	2 15		
	Owners Copper				
1 3/4 Cx	I.W.H. Stop & Waste		4 96		
1 Hr.	trucking @ .75		75		NON CHARGE
			<u>7 86</u>	6' 3/4"	Copper Tubing @ .4850 2 91
				1 3/4	C. Corp Cock 4 34
				1 3/4	C Curb Cock 5 94
				1	Box & Rod 4 62
				1 1/2	Straight Tail piece 50
				1 1/2	Offset Tail piece 50
					<u>20 76</u>

DATE \_\_\_\_\_

**TOWN OF LEXINGTON — BOARD OF PUBLIC WORKS**  
**WATER DIVISION**

Sketch of Service Here

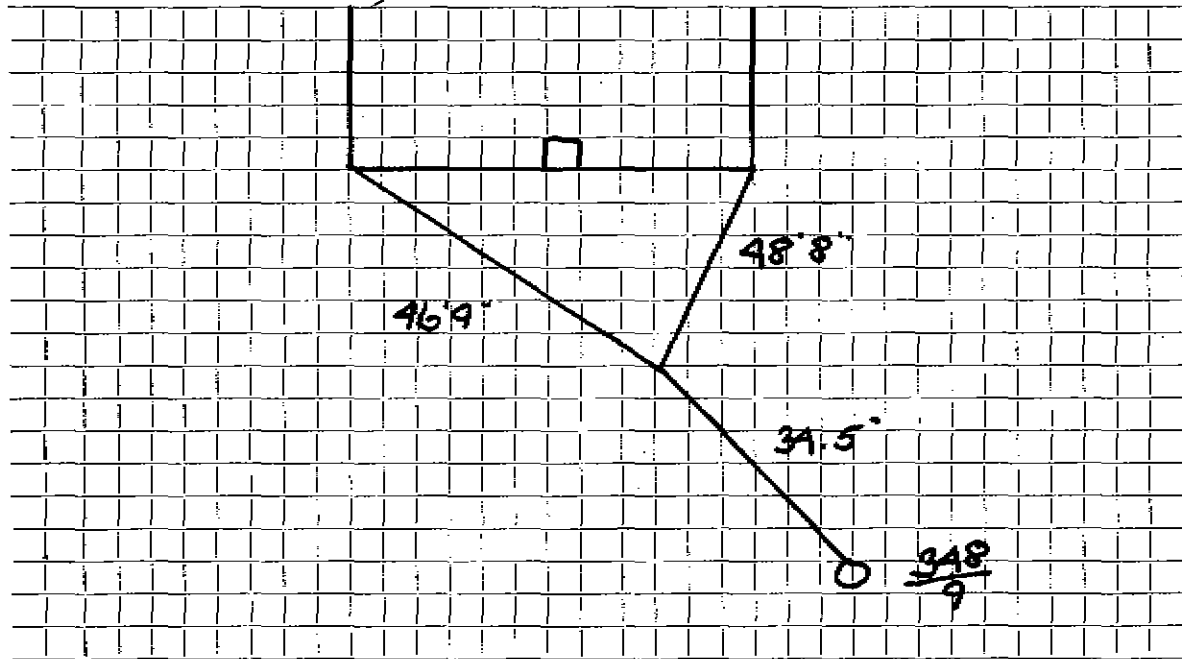

Connection made in ..... Street. Work completed .....

Remarks: .....

.....

.....