

WATER SERVICE RECORD

Name DeVries Construction Company

Service No. 273 N.D

Address 2 Blueberry Lane

Location # 3186

Repair—Renewal—New Service

Comm 9-24-56


Date	Material	Amount	Total	Date	Amount
4/3/56	Labor	1 95		9-24-56	21 28
	10% overhead	20	2 15	"	18 44
	61' 3/4" copper tubing @ .4850		29 59		<u>39 72</u>
	1 3/4" C Union 3 Part		2 27		NON CHARGES
	1 3/4" C x 1/2" I.W.H. stop&waste		4 96	Labor	1 95
	1 hr. trucking @ .75		75	7' 3/4" copper tubing @ .4850	3 40
			39 72	1 3/4" C Corp Cock	4 34
				1 3/4" C Curb Cock	5 94
				1 Box & Rod	4 62
				1 1/2 Straight tail piece	50
				1 1/2 Offset tail piece	50
					<u>21 25</u>

DATE \_\_\_\_\_

TOWN OF LEXINGTON — BOARD OF PUBLIC WORKS

**WATER DIVISION**

Sketch of Service Here

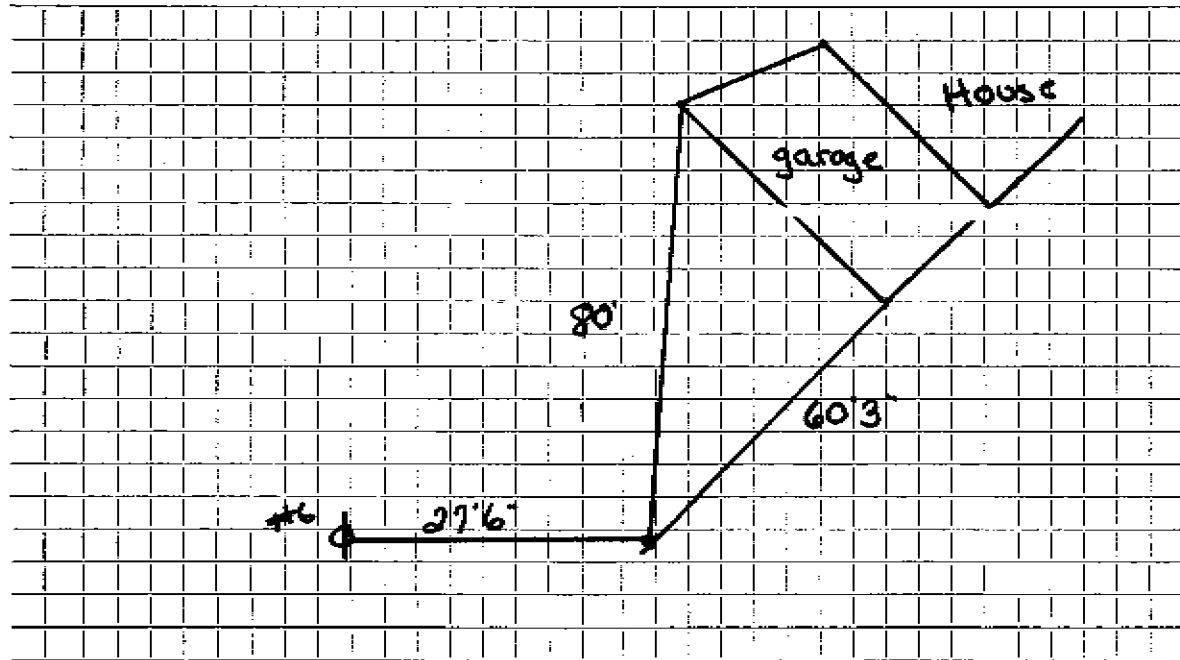

Connection made in \_\_\_\_\_ Street. Work completed \_\_\_\_\_

Remarks: \_\_\_\_\_

\_\_\_\_\_  
\_\_\_\_\_