

WATER SERVICE RECORD

Service No. 268 N.D.

Name DeVries Construction Company

Address 20 Blueberry Lane

Location

~~Repair~~ ~~Emergency~~ New Service

Comm. 9-24-56

| Date | Material | Amount | Total | Date | Amount |
|------------------------|--------------------------|--------|-------|-----------------|----------------------|
| 6/16/56 | Labor | 1 95 | | 10-8-56 | |
| | 10% overhead | 20 | 2 15 | | |
| | Copper supplied by owner | | | | |
| 1 3/4 CX $\frac{3}{4}$ | I.W.H. Stop & Waste | | 4 96 | | |
| 1 | hr. trucking @.75 | | 75 | | |
| | | | 7 86 | | |
| | | | | 21 3/4" | NON CHARGE |
| | | | | | Copper tubing @.4850 |
| | | | | 1 3/4 | Corp Cock |
| | | | | 1 3/4 | Curb Cock |
| | | | | 1 | Box & Rod |
| | | | | 1 $\frac{1}{8}$ | Straight tail piece |
| | | | | 1 $\frac{1}{8}$ | Offset tail piece |
| | | | | | 28 04 |


Paid by Ref. ^{m.N.C.} #147

DATE _____

TOWN OF LEXINGTON — BOARD OF PUBLIC WORKS

WATER DIVISION

Sketch of Service Here

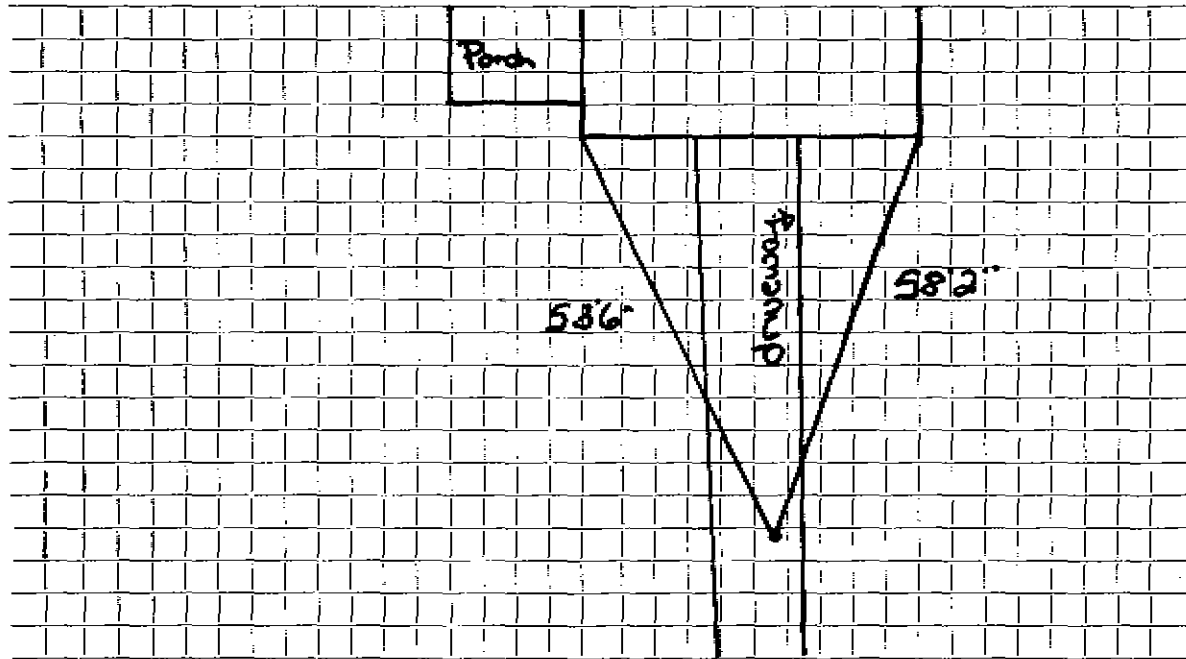

Connection made in Street. Work completed

Remarks:
.....
.....