

## WATER SERVICE RECORD

Service No. 269 N.D.

Name DeVries Construction Company

Address

21 Blueberry Lane

Location

~~Repair~~ ~~Renewal~~ - New Service

Comm 9-24-56

Date	Material	Amount	Total	Date	Amount
6/16/56	Labor	1 95		10-8-56	7 86
	10% overhead	20	2 15		
	Owners copper				
1 3/4 Cx $\frac{1}{2}$	I.W.H. Stop & Waste		4 96		
1 hr.	trucking @ .75		75		
			7 86		
				7' 3/4" Copper tubing @.4850	3 40
				1 3/4 C.Corp Cock	4 34
				1 3/4 C.Curb Cock	5.94
				1 Box & Rod	4 62
				1 $\frac{1}{2}$ Straight tail piece	50
				1 $\frac{1}{2}$ Offset tail piece	50
					21 25

Paid by Refans W.H.C #149


NON CHARGE

DATE \_\_\_\_\_

TOWN OF LEXINGTON — BOARD OF PUBLIC WORKS

WATER DIVISION

Sketch of Service Here

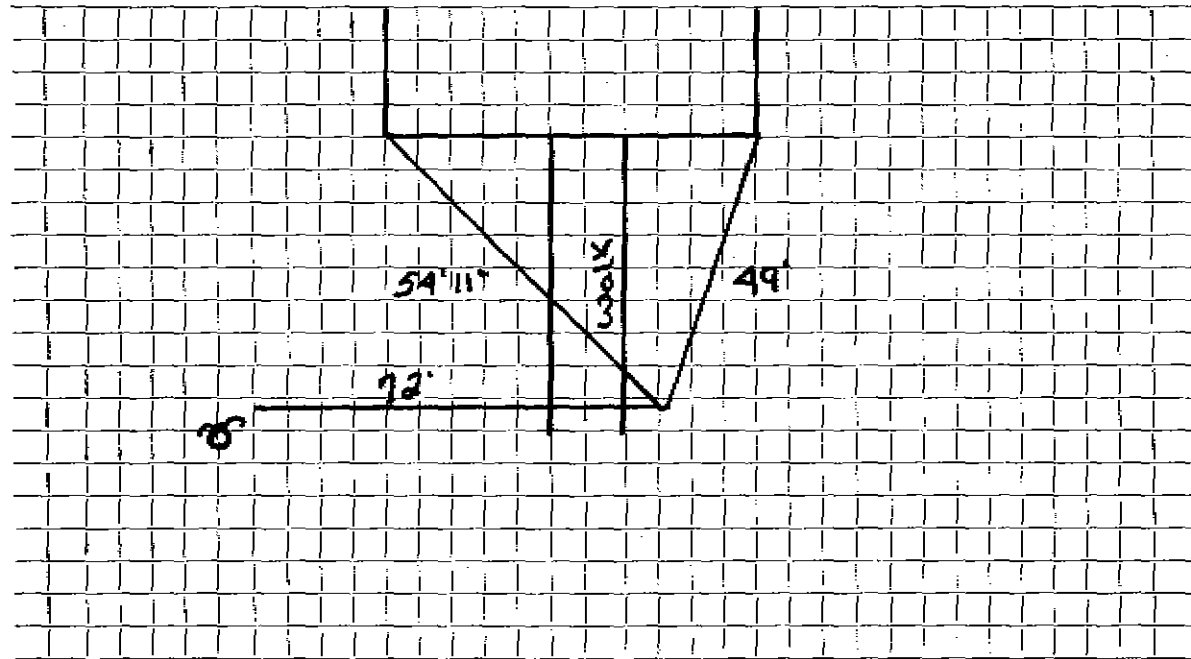

Connection made in ..... Street. Work completed .....

Remarks: .....

.....  
.....