

WATER SERVICE RECORD

Service No. N.D. 271

Name DeVries Construction Company

Address 22 Blueberry Lane

Location

~~Renov. Brass~~ New Service

Comm 9-24-56

Date	Material	Amount	Total	Date	Amount
6/17/56	Labor	1 95		9-24-56	
	10% overhead	20	2 15		
	Owners copper				
1	3/4 Cx# I.W.H. Stop & Waste		4 96		
1	hr trucking @ .75		75		
			7 86		
				22'	3/4" Copper tubing @ .4850 10.67
				1	3/4 Corp Cock 4 34
				1	3/4 Curb Cock 5 94
				1	Box & Rod 4 62
				1	3/8 Straight tail piece 50
				1	3/8 Offset tail piece 50
					28.52


*Pd. by Ref on W.H.C. #149 #*

NON CHARGE

DATE \_\_\_\_\_

TOWN OF LEXINGTON — BOARD OF PUBLIC WORKS  
WATER DIVISION

Sketch of Service Here

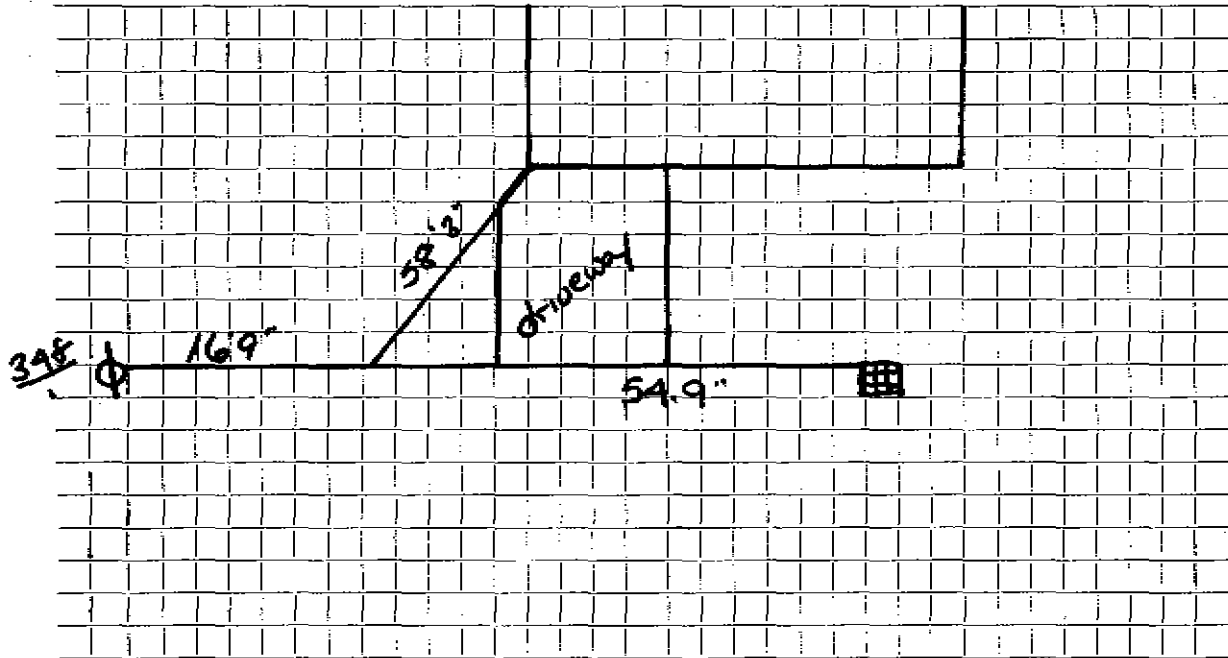

Connection made in ..... Street. Work completed .....

Remarks: .....  
.....  
.....