

WATER SERVICE RECORD

Name DeVries Construction Company

Service No. 291 N.D.

Address 23 Blueberry Lane

7272

Location

~~Water Service~~ - New Service

Comm 9-24-56


Date	Material	Amount	Total	Date		Amount
6/16/56	Labor	1 95		9-24-56	Pd. by Ref. on W. H. C #152	7 86
	10% overhead	20	2 15			
	Owners copper					
1 3/4 Cx 1/2	T.W.H. Stop & Waste		4 96			
1 hr	trucking @ .75		75		Non Charge	
			7 86	7' 3/4"	Copper tubing @ .4850	3 40
				1 3/4	C. Corp Cock	4 34
				1 3/4	C. Curb. Cock	5 94
				1	Box & Rod	4 62
				1 1/2	Straight tail piece	50
				1 1/2	Offset tail piece	50
						21.25

DATE _____

TOWN OF LEXINGTON — BOARD OF PUBLIC WORKS

WATER DIVISION

Sketch of Service Here

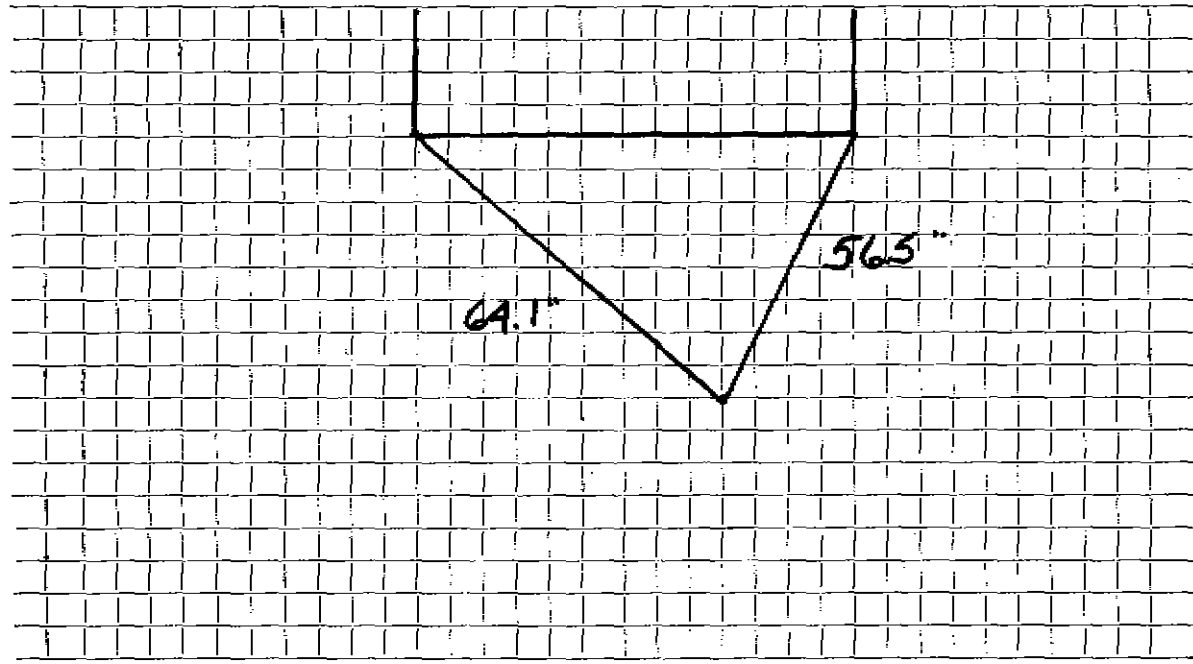

Connection made in Street. Work completed

Remarks:
.....
.....