

WATER SERVICE RECORD

Service No. 293 N.D.

Name DeVries Construction Company

Address 26 blue berry Lane

Location

~~REPAIR~~ - New Service

Comm 9-24-54

7813


Date	Material	Amount	Total	Date	Amount
6/16/56	Labor	1 95		9-24-56	Pl. by Ret. on work # 154
	10% overhead	20	2 15		
	Owners copper				
1 3/4 Cx 1/2	I W H Stop & Waste		4 96		
1 hr. trucking @ / .75			75		
			7.86		NON CHARGE
				22" 3/4" Copper tubing @ .4850	10.67
				1 3/4 C. Corp Cock	4 34
				1 3/4 C. Curb Cock	5 94
				1 Box & Rod	4 62
				1 1/2 Straight tail piece	50
				1 1/2 Offset tail piece	50
					28 52

DATE _____

TOWN OF LEXINGTON — BOARD OF PUBLIC WORKS

WATER DIVISION

Sketch of Service Here

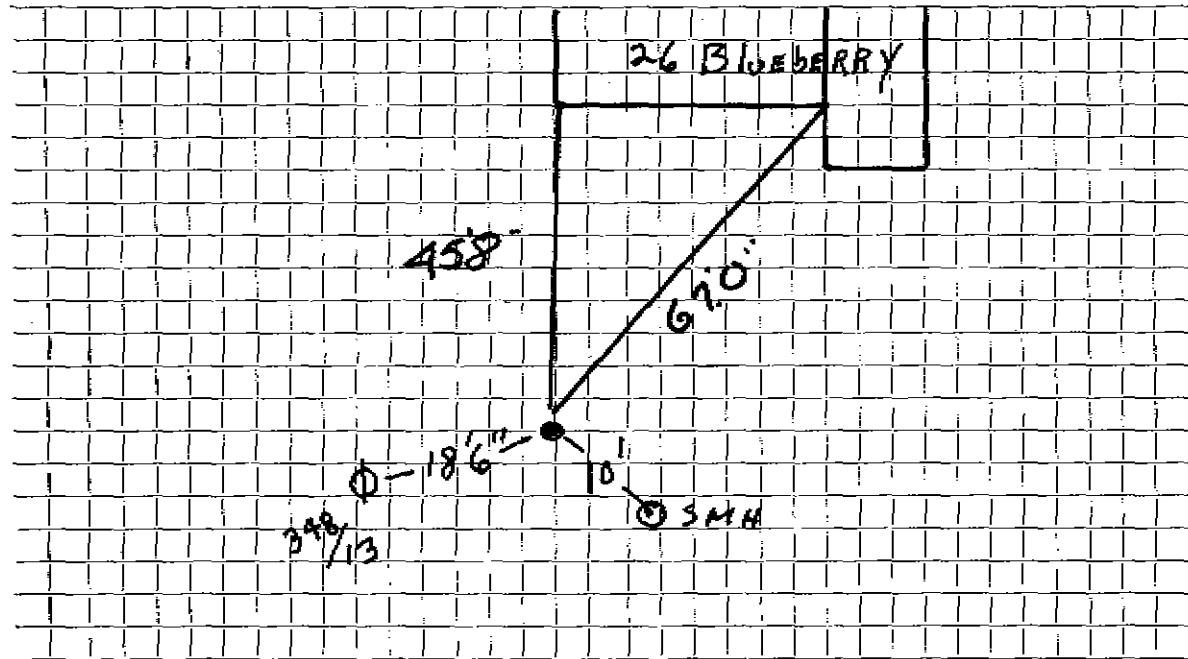

Connection made in Street. Work completed

Remarks:

.....
.....