

WATER SERVICE RECORD

4813

Name DeVries Construction Company

Service No. 294 N.D.

Address 28 Blueberry Lane

Location

New Service

Comm - 9-24-56


Date	Material	Amount	Total	Date	Material	Amount
6/16/56	Labor	1 95		9-24-56	1/4" by 1/2" galvanized pipe	7 56
	10 % overhead	20	2 15			
	1/4" dia. 1/2" x 2' pipe & waste		4 95			
	for trucking @ .75		75			
			9 86			
				35'	3/4" Copper tubing @ .4850	16 98
				1	3/4" C. Corp Cock	4 24
				1	3/4" C. Gurb Cock	5 94
				1	Box & Red	1 62
				1	1/2" Straight tail piece	50
				1	1/2" Offset tail piece	50
						34 83

DATE

TOWN OF LEWINGTON — BOARD OF PUBLIC WORKS

WATER DIVISION

Sketch of Service Line

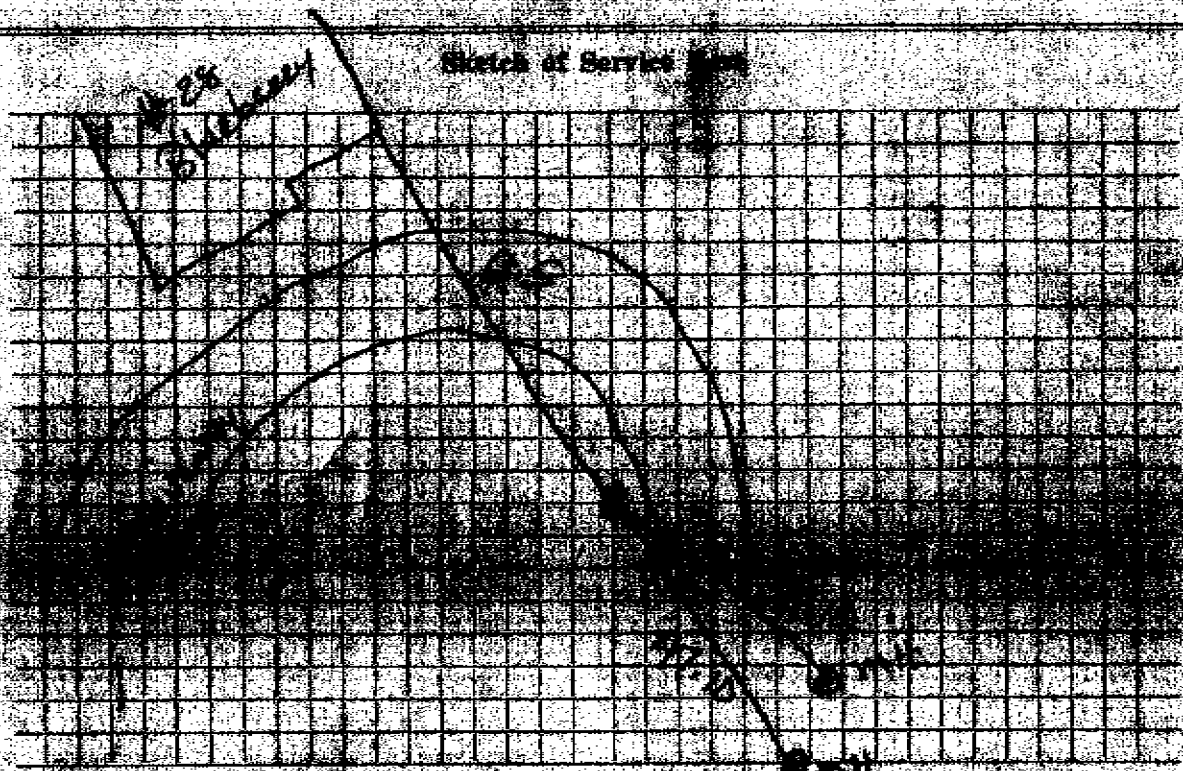

Connection made in Street Work completed

Remarks: