

WATER SERVICE RECORD

Name DeVries Construction Company

Service No. 146 (1956)

Address 8 Blueberry Lane

Location

~~Repair & Renovation~~ - New Service

Comm. 9/30/57


Date	Material	Amount	Total	Date	Amount
7/8/57	Labor	1 95		6-8-56	Deposit \$ 50 00
	10% overhead	20	2 15	9-30-57	Refund (28 26
	37' - 3/4" Copper tubing @	.375	13 88		NON CHARGE \$ 21 74
	1 - 3/4" Cx 1/2 I.W.H. Stop & Waste		4 96	7/8/57	Labor 1 95
	1 hr. Trucking		75	27' - 3/4" Copper tubing @	.375 10 13
			21 74	1 - 3/4" C. Corp Cock	4 64
				1 - 3/4" C. Curb Cock	5 94
				1 Box & Rod	4 62
				1 - 1/2" Straight tailpiece	50
				1 - 1/2" Offset tailpiece	50
					28 28

DATE _____

TOWN OF LEXINGTON — BOARD OF PUBLIC WORKS

WATER DIVISION

Sketch of Service Here

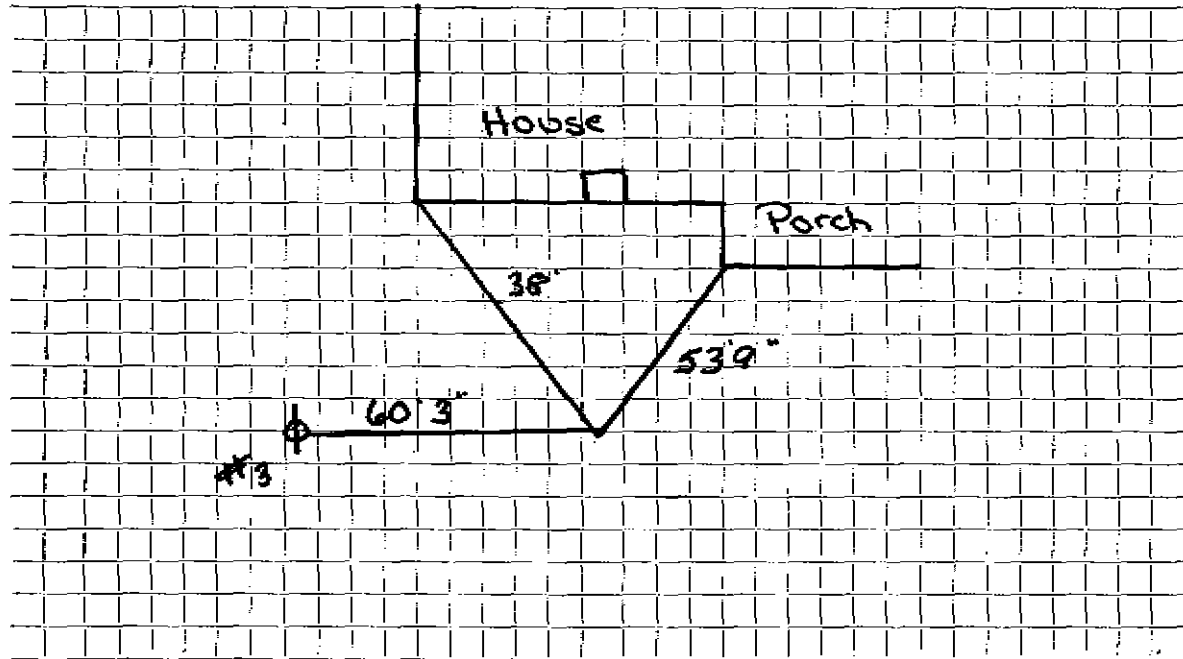

Connection made in Street. Work completed

Remarks:
.....
.....