

## WATER SERVICE RECORD

Name DeVries Construction Company

Service No. 147

Address 9 Blueberry Lane

Location

Repair—Renewal—New Service

Comm - 9-24-56


Date	Material	Amount	Total	Date	Amount
6/13/56	Labor	1 95		6-8-56	Deposit \$ 50 00
	10% overhead	20	2 15	9-24-56	Refund 22 25
	41' 3/4" copper tubing @ .4850		19 89		<u>NON CHARGES</u> 27 75
	1 3/4" C x 1/8" I.W.H. stop&waste		1 96		
	1 hr. trucking @ .75		75	Labor	1 95
			27 75	8' 3/4" copper tubing @ .4850	3 88
				1 3/4" C corp Cock	4 34
				1 3/4" C Curb Cock	5 94
				1 Box & Rod	4 62
				1 1/2 straight tail piece	50
				1 1/2 offset tail piece	50
					21 73
				* \$ 6.37 applied to W.H.C. # 266	
				7.86 " " " " 267	
				7.86 " " " " 268	
				<u>22.09</u>	

DATE \_\_\_\_\_

TOWN OF LEXINGTON — BOARD OF PUBLIC WORKS

WATER DIVISION

Sketch of Service Here

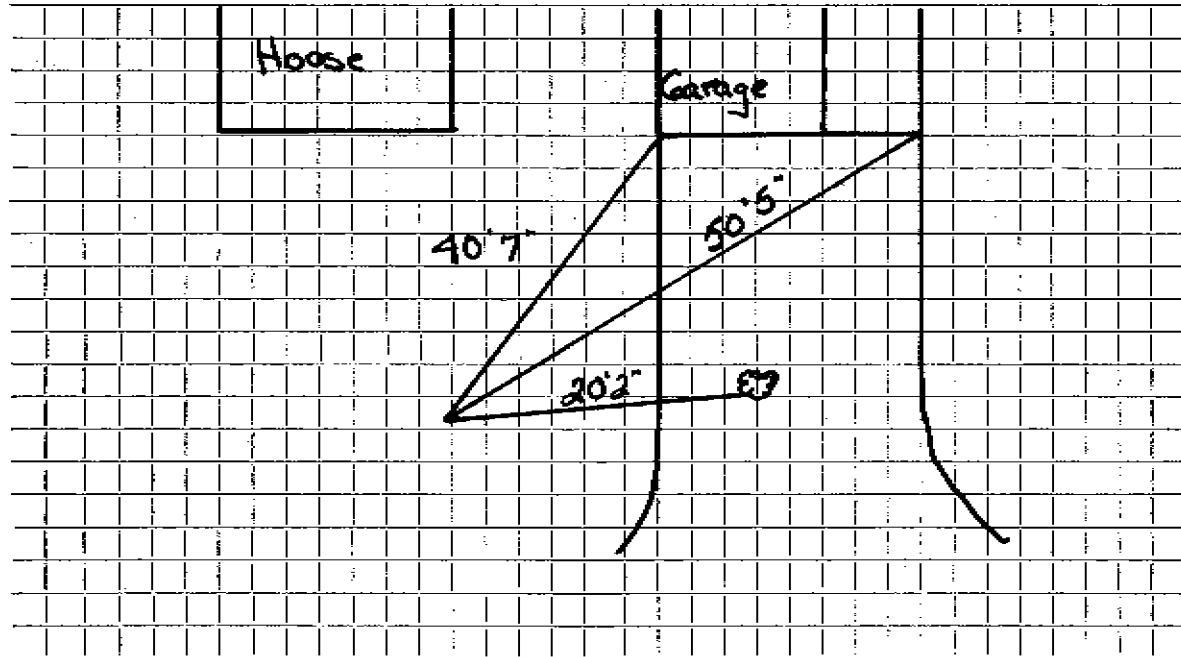

Connection made in ..... Street. Work completed .....

Remarks: .....  
.....  
.....