


TOWN OF LEXINGTON — BOARD OF PUBLIC WORKS

WATER DIVISION

DATE 9/2021

Sketch of Service Here

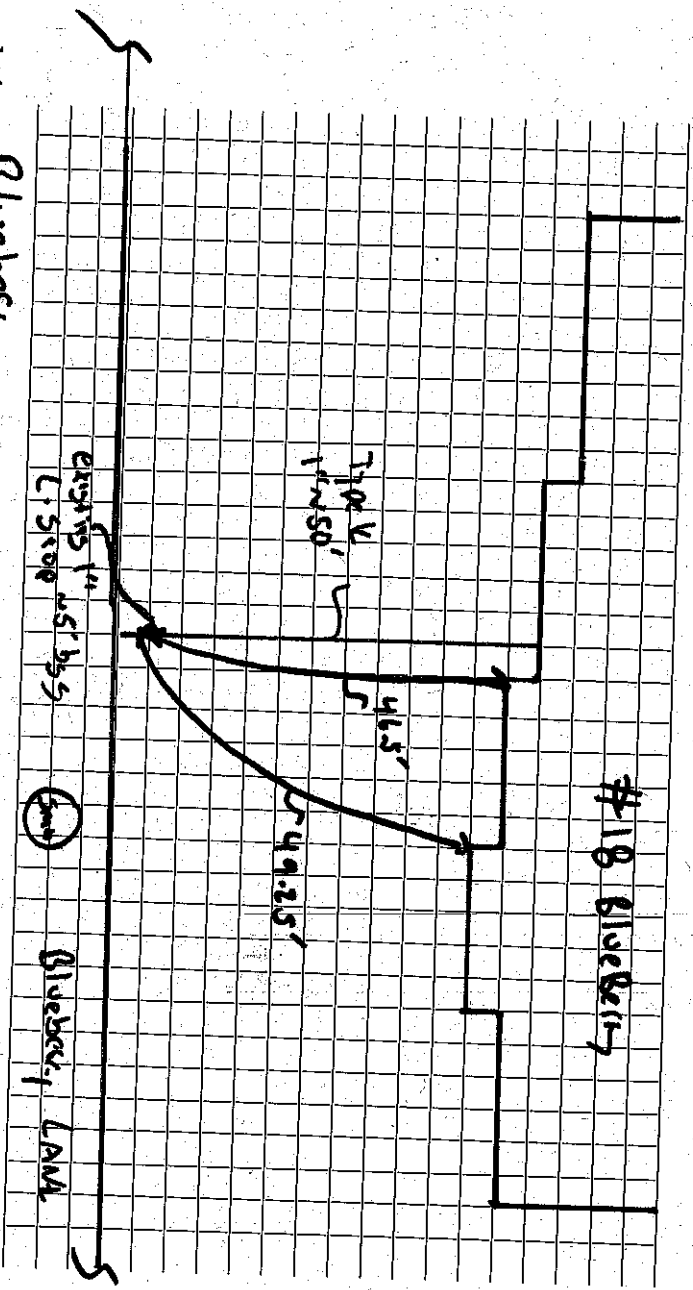

Connection made in BlueBerries

Street

Work completed

Remarks:

WATER SERVICE RECORD

Name DeVries Construction Company

Service No. *N.D.* 266

Address 18 Blueberry Lane

Location


~~Repair - Renewal~~ - New Service

Comm 9-24-56

Date	Material	Amount	Total	Date	Amount
	Labor	1 95		9-24-56	
	10% overhead	20	2 15	<i>Pd. by Refunds</i>	\$ 25 81
	37' 3/4" Copper tubing @.4850		17 95		
1	3/4 c x 1/2 I W H. Stop & Waste		4 96		
1	hr trucking @ .75		75		
			25 81		
				22' 3/4" copper tubing @.4850	10 67
				1 3/4 C. Corp Cock	4 34
				1 3/4 C. Curb Cock	5 94
				1 Box & Rod	4 62
				1 1/2 Straight tail piece	50
				1 1/2 Offset tail piece	50
				1 hr. trucking @ .75	75
					29 27

TOWN OF LEXINGTON — BOARD OF PUBLIC WORKS
WATER DIVISION

Sketch of Service Here

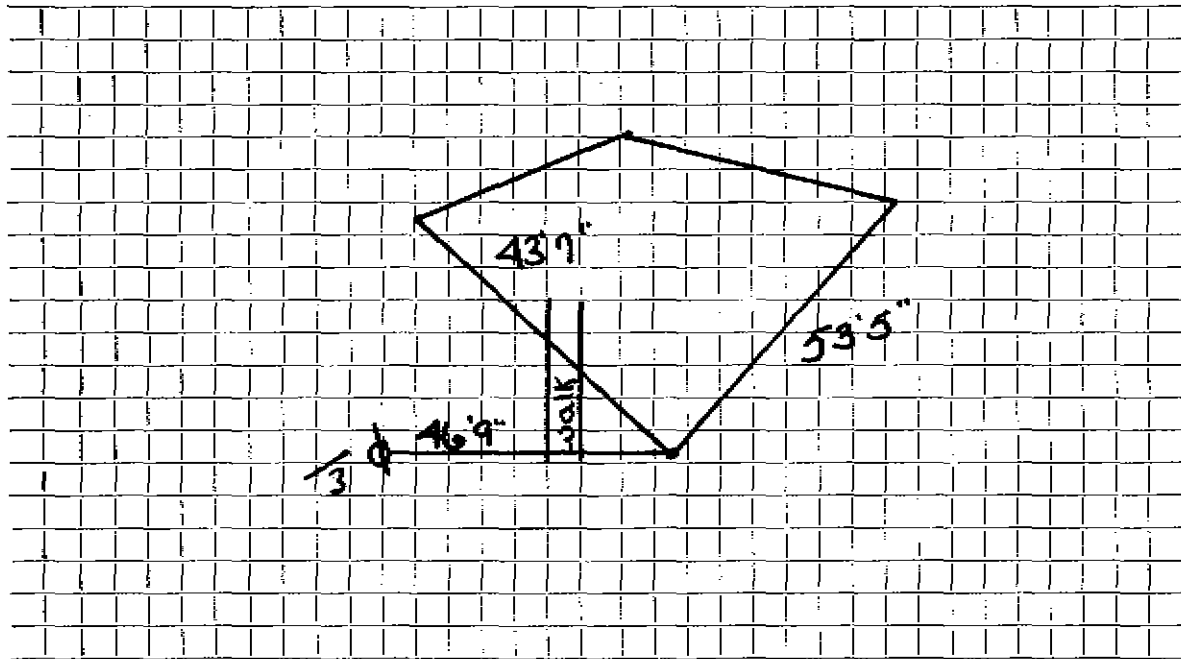

Connection made in Street. Work completed

Remarks:
.....
.....